


# T.6S.,R.4E.,W.M.

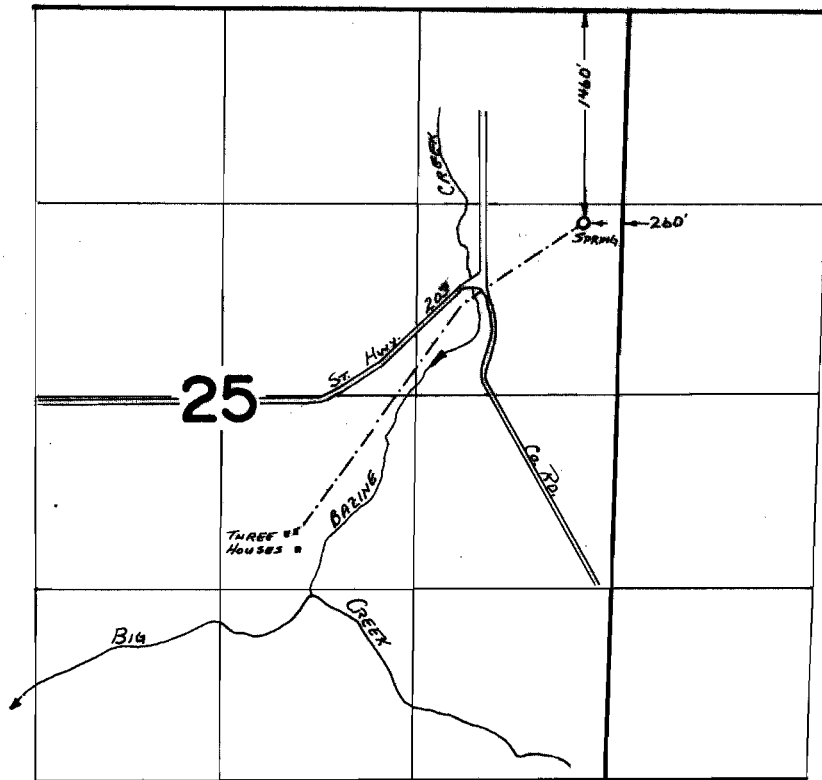

## FINAL PROOF SURVEY UNDER

Application No. 48207 Permit No. 36207  
IN NAME OF

KEVIN J. & LESLIE MCNAMARA

Surveyed SEPT. 19 1974, by L. H. NUNN