


T. 1S., R. 39E., W.M.

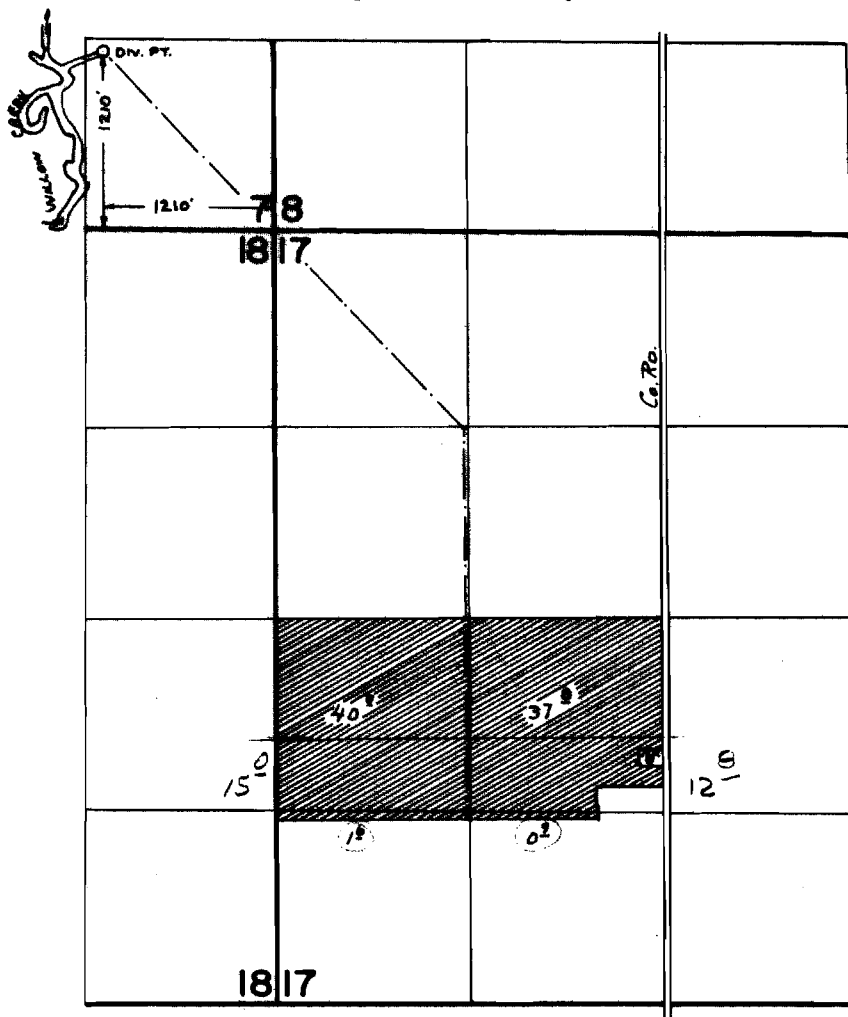

FINAL PROOF SURVEY UNDER

OVERCREEP
IN PENCIL

Application No. 49695 Permit No. 37203
IN NAME OF

GEORGE ROYES

Surveyed Sec. 11, 1974, by L. H. NUNN