


T.2N.,R.14E.,W.M.

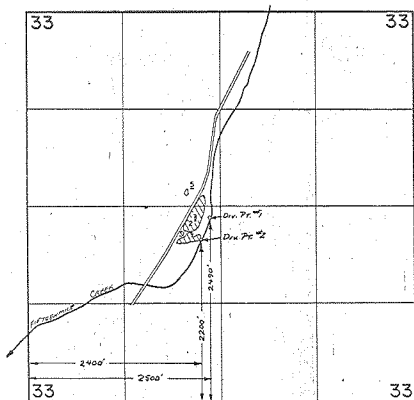

FINAL PROOF SURVEY
UNDER

Application No. 45168... Permit No. 33747...
IN NAME OF

VERNON H. & ARRA CRAWFORD

Surveyed April 25 1974, by D. NORBY.....