


T.1S.R.13E.W.M.

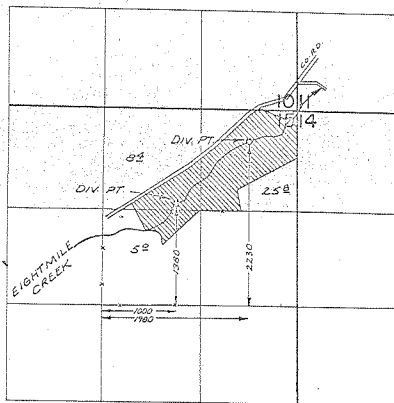

FINAL PROOF SURVEY
UNDER

Application No. 49300... Permit No. 37013...
IN NAME OF

.....JAMES H. & LEAH E. DARNIELLE.....

Surveyed APR. 23 1974, by D. NORBY.....