


T.9&10S.R.22E.W.M.

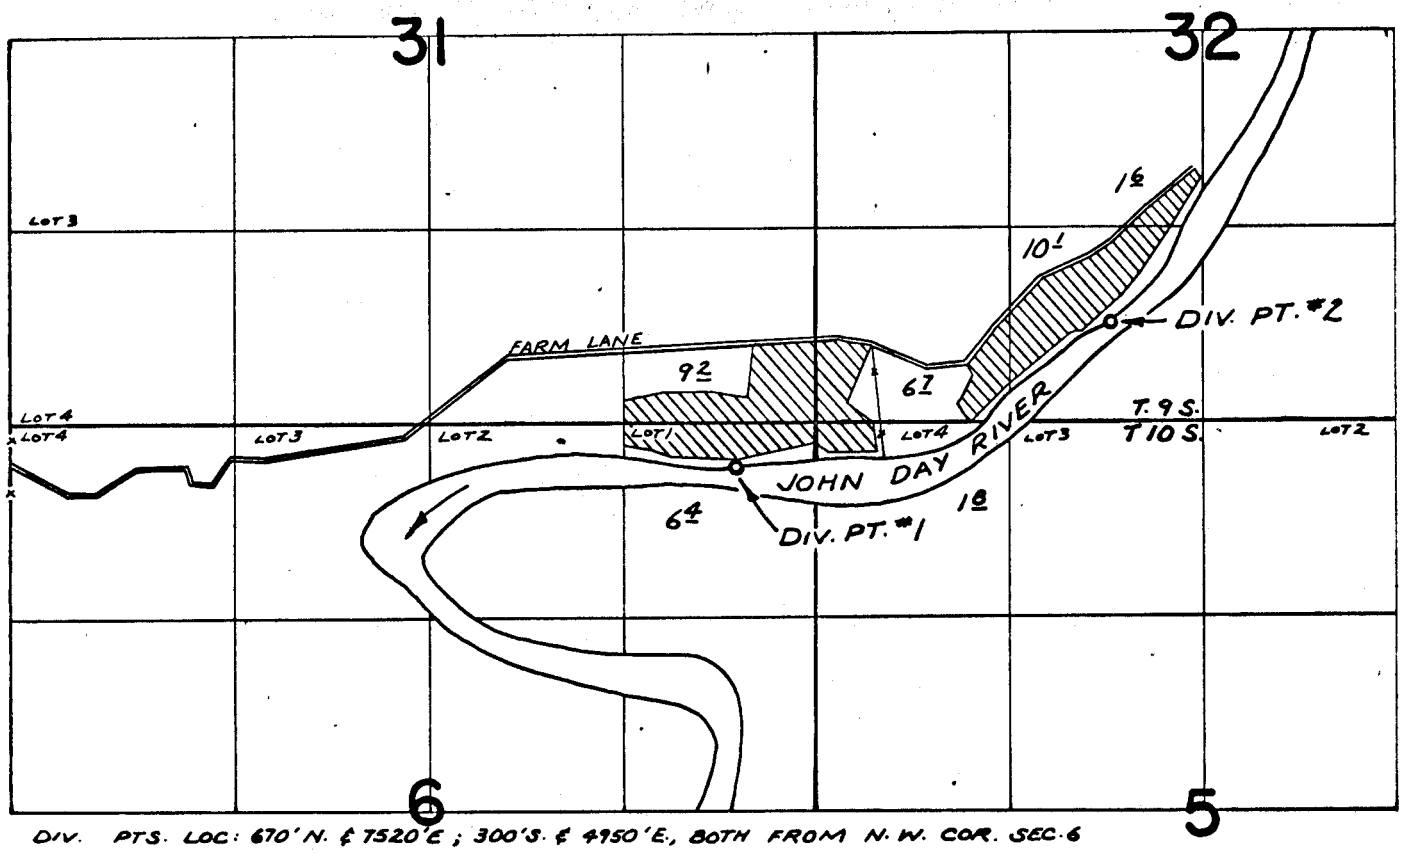

FINAL PROOF SURVEY
UNDER

Application No. 47126 Permit No. 35288
IN NAME OF

ZACK T. KEYS

Surveyed July 18, 1974, by R. MUCKEN