


T. 7S. R. 38E. W.M.

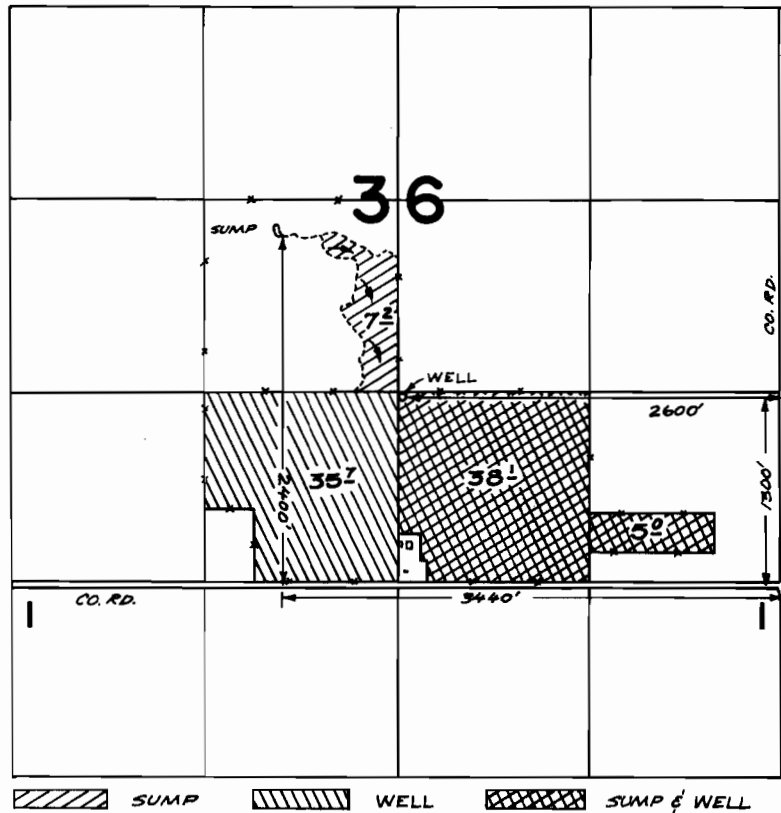

FINAL PROOF SURVEY UNDER

Application No. G4081 Permit No. G3835
IN NAME OF

DONALD WILLIAM CHRISTY

Surveyed OCT. 24 1974, by L.M.TOLL