


T.14S. R. 4W. W.M.

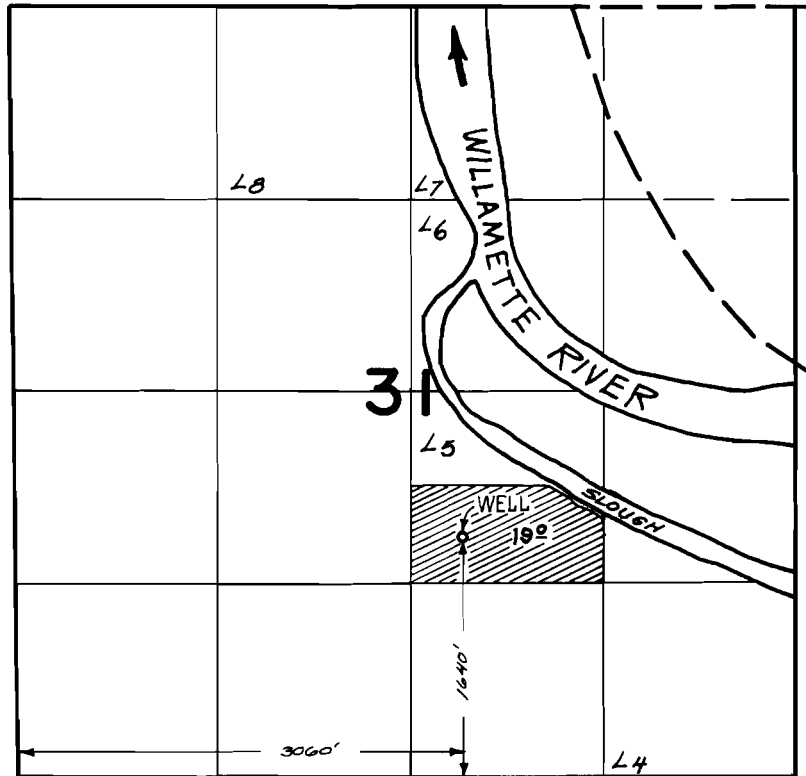

FINAL PROOF SURVEY
UNDER

Application No. 65128 Permit No. 64865
IN NAME OF

JAMES R. & MILDRED CROWSON

Surveyed NOV. 6 1974, by L.M. TOLLE