T. 14 S. R. 8 W. W. M.

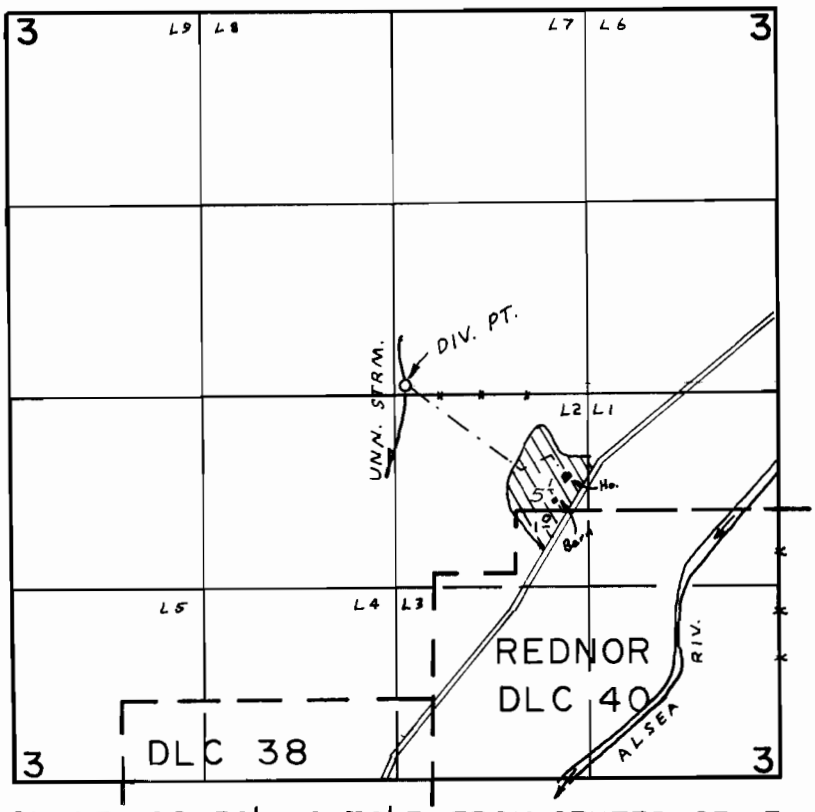

DIV. PT. LOC. 50' N. & 70' E. FROM CENTER SEC. 3

FINAL PROOF SURVEY
UNDER

Application No. 47612 Permit No. 35637
IN NAME OF

THOMAS C. CANTRELL

Surveyed JUN 3 1974, by L H NUNN

DFS-3LL-289 LHN