


T.3S. R.1W. W.M.

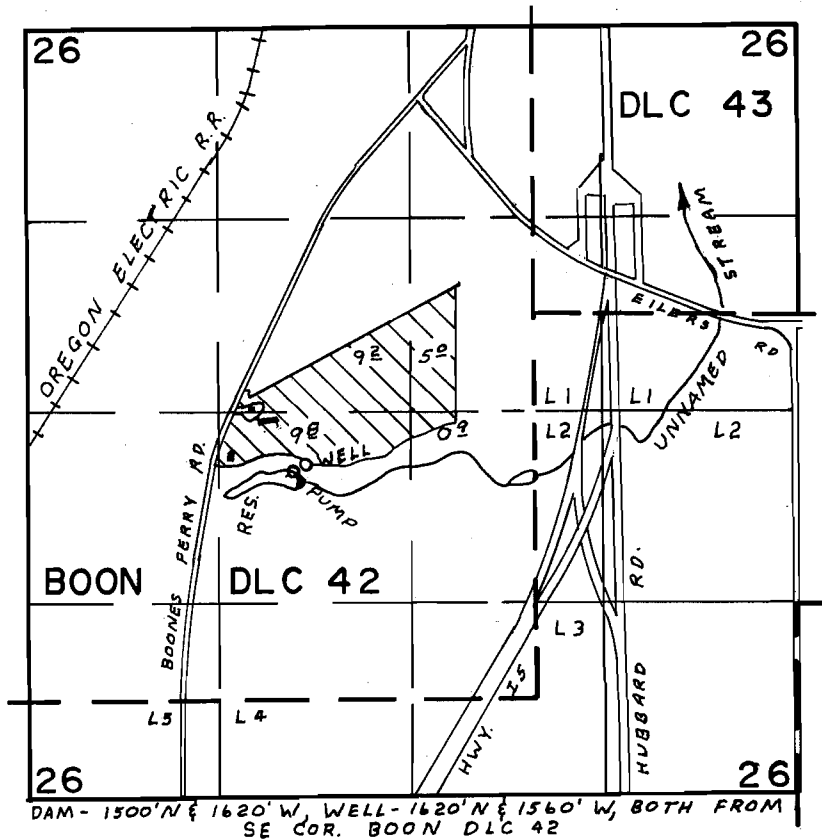

FINAL PROOF SURVEY UNDER

G-4967 G-4687
 R-46345 R-5514
 Application No. 46346 Permit No. 34623
 IN NAME OF

FRANK MORISHITA, FAIRDALE NURSERY CO.

Surveyed AUG 13, 1974, by L.H. NUNN