


# T.5 S. R.1 E. W.M.

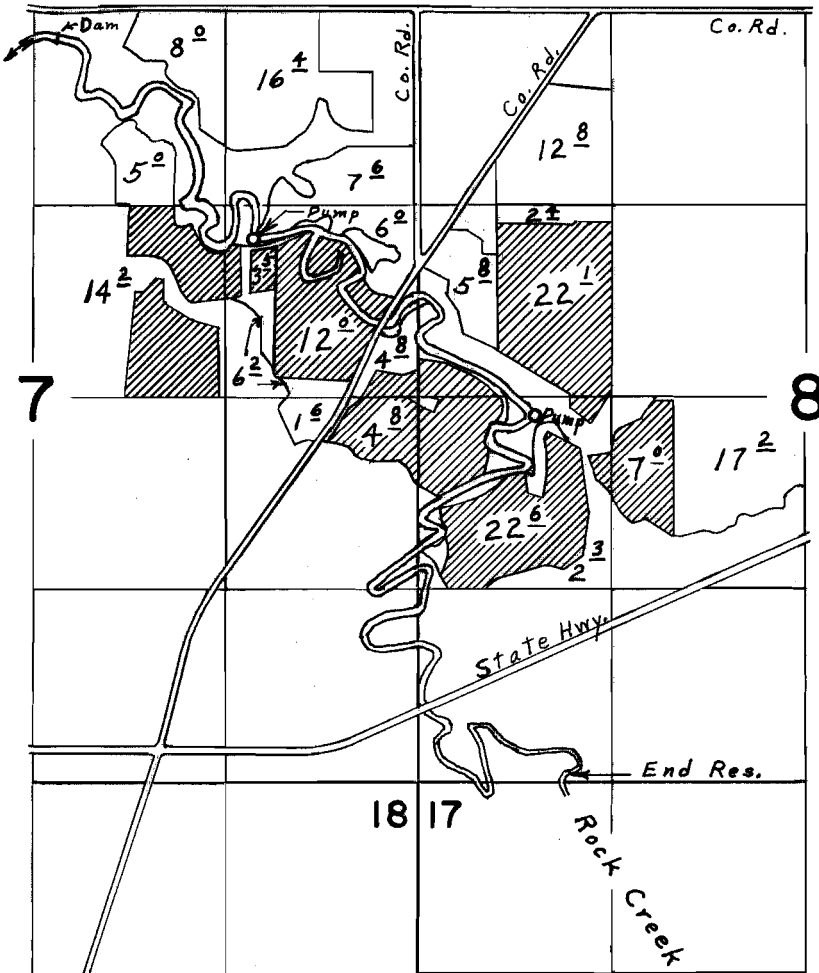

Div. Pt. located 180'S. & 2460' W. from N.E. Cor. Sec. 7

## FINAL PROOF SURVEY UNDER

R-44295 R-5122  
Application No. 44296 Permit No. 33083  
IN NAME OF

AAMODT DAIRY INC.

Surveyed June 20, 1974, by L. E. Gould