


T.3S. R.1W. W.M.

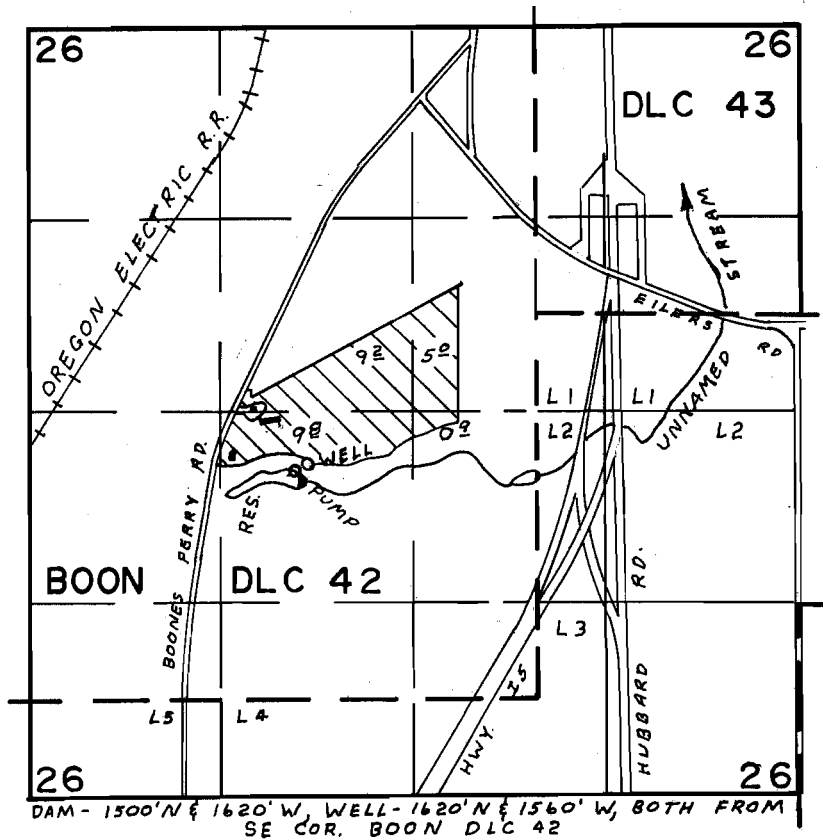

FINAL PROOF SURVEY UNDER

G-4967 G-4687
R-46345 R-5514
Application No. 46346... Permit No. 34623...
IN NAME OF

FRANK MORISHITA, FAIRDALE NURSERY CO.

Surveyed AUG. 13. 1974, by L.H. NUNN.....