


T.4 N. R.1 & 2 W. W.M.

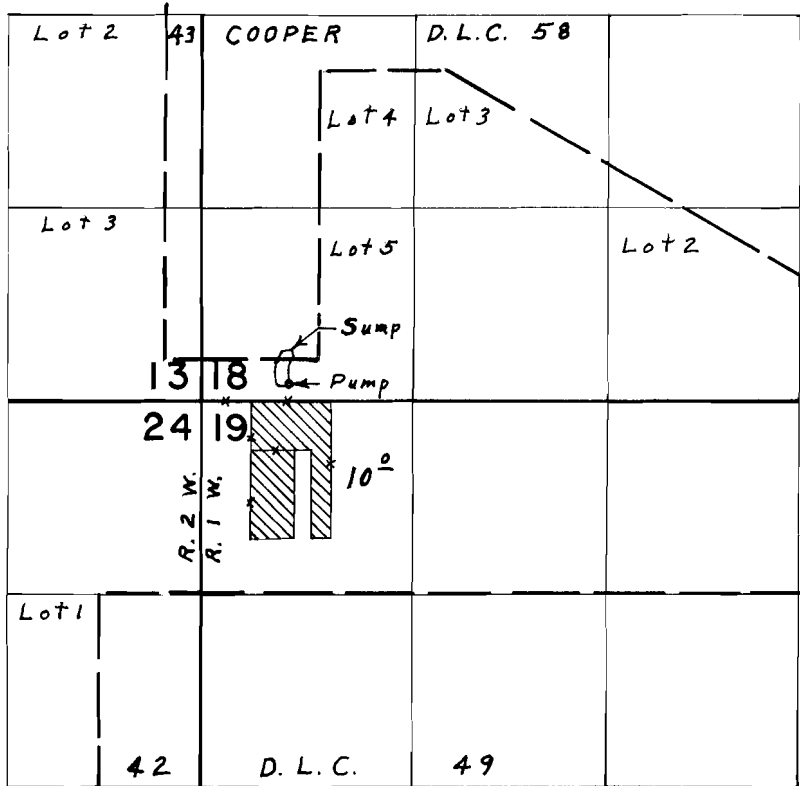

Sump loc. 200' N. & 550' E. from S. W. Cor. Sec. 18

FINAL PROOF SURVEY UNDER

Application No. G-5260 Permit No. G-4781
IN NAME OF

ALBERT H. & LORETTA A. SCHMIT

Surveyed June 27, 1974, by L. E. Gould