


T.3 N. R.2 W. W.M.

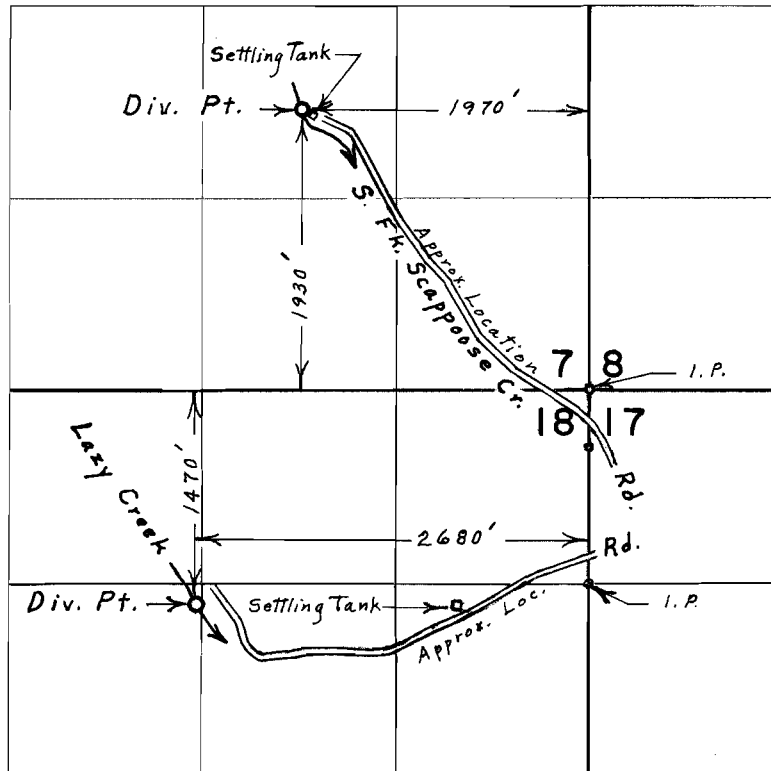

**FINAL PROOF SURVEY**  
UNDER

Application No. 27859 Permit No. 259/8  
IN NAME OF

**CITY OF SCAPPOOSE**

Surveyed June 25, 1974, by L. E. Gould