


T.7N. R.5W. W.M.

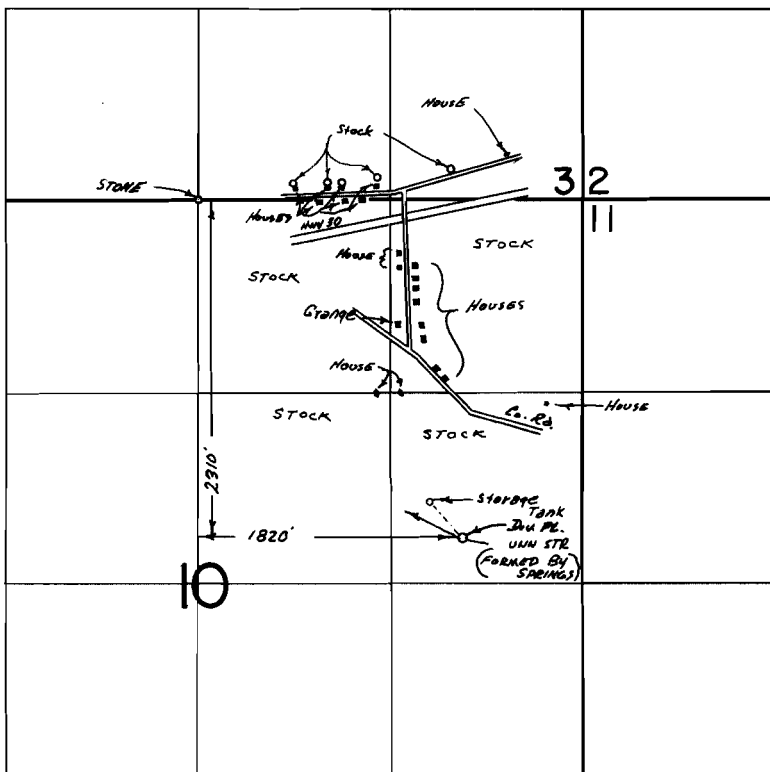

**FINAL PROOF SURVEY**  
UNDER

Application No. 40869.. Permit No. 31404....  
IN NAME OF

MARSHLAND WATER ASSOCIATION

Surveyed Oct...1..... 1974, by L...H...NUNN....