


T.6&7N. R.3W. W.M.

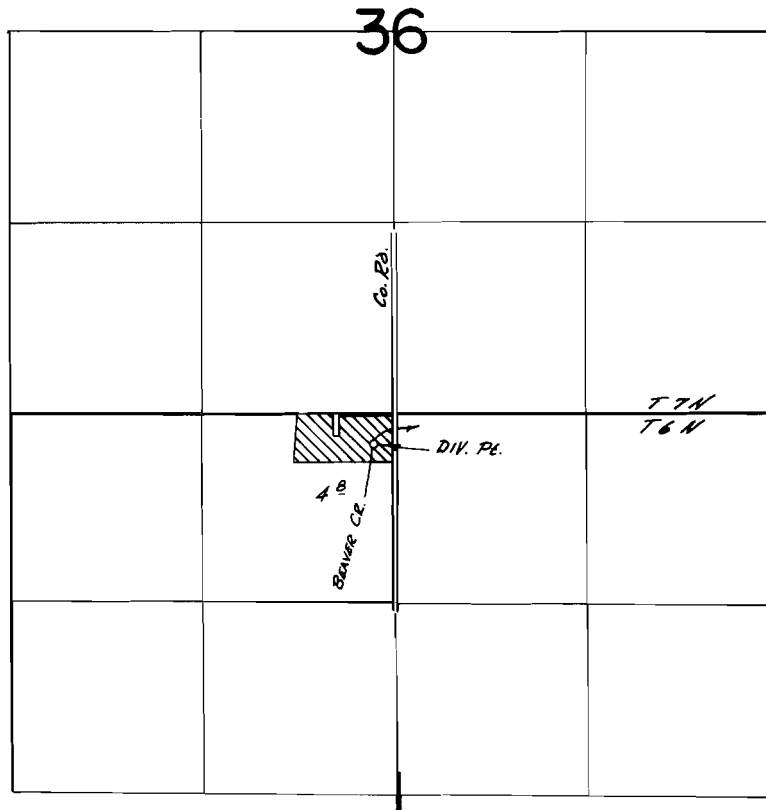

Div Pl Loc 220' S & 150' W FROM N 1/4 Co R SEC 1

FINAL PROOF SURVEY
UNDER

Application No. 45889 Permit No. 34264
IN NAME OF

LAWRENCE F BECK

Surveyed Oct. 3, 1974, by L. H. NUNN