


JUL 12 1968
 PHILIP DEWEY
 REGISTERED LAND SURVEYOR
 COLUMBIA COUNTY, OREGON

West $\frac{1}{4}$ Cor.

N.E. Cor. N.W. $\frac{1}{4}$ S.W. $\frac{1}{4}$

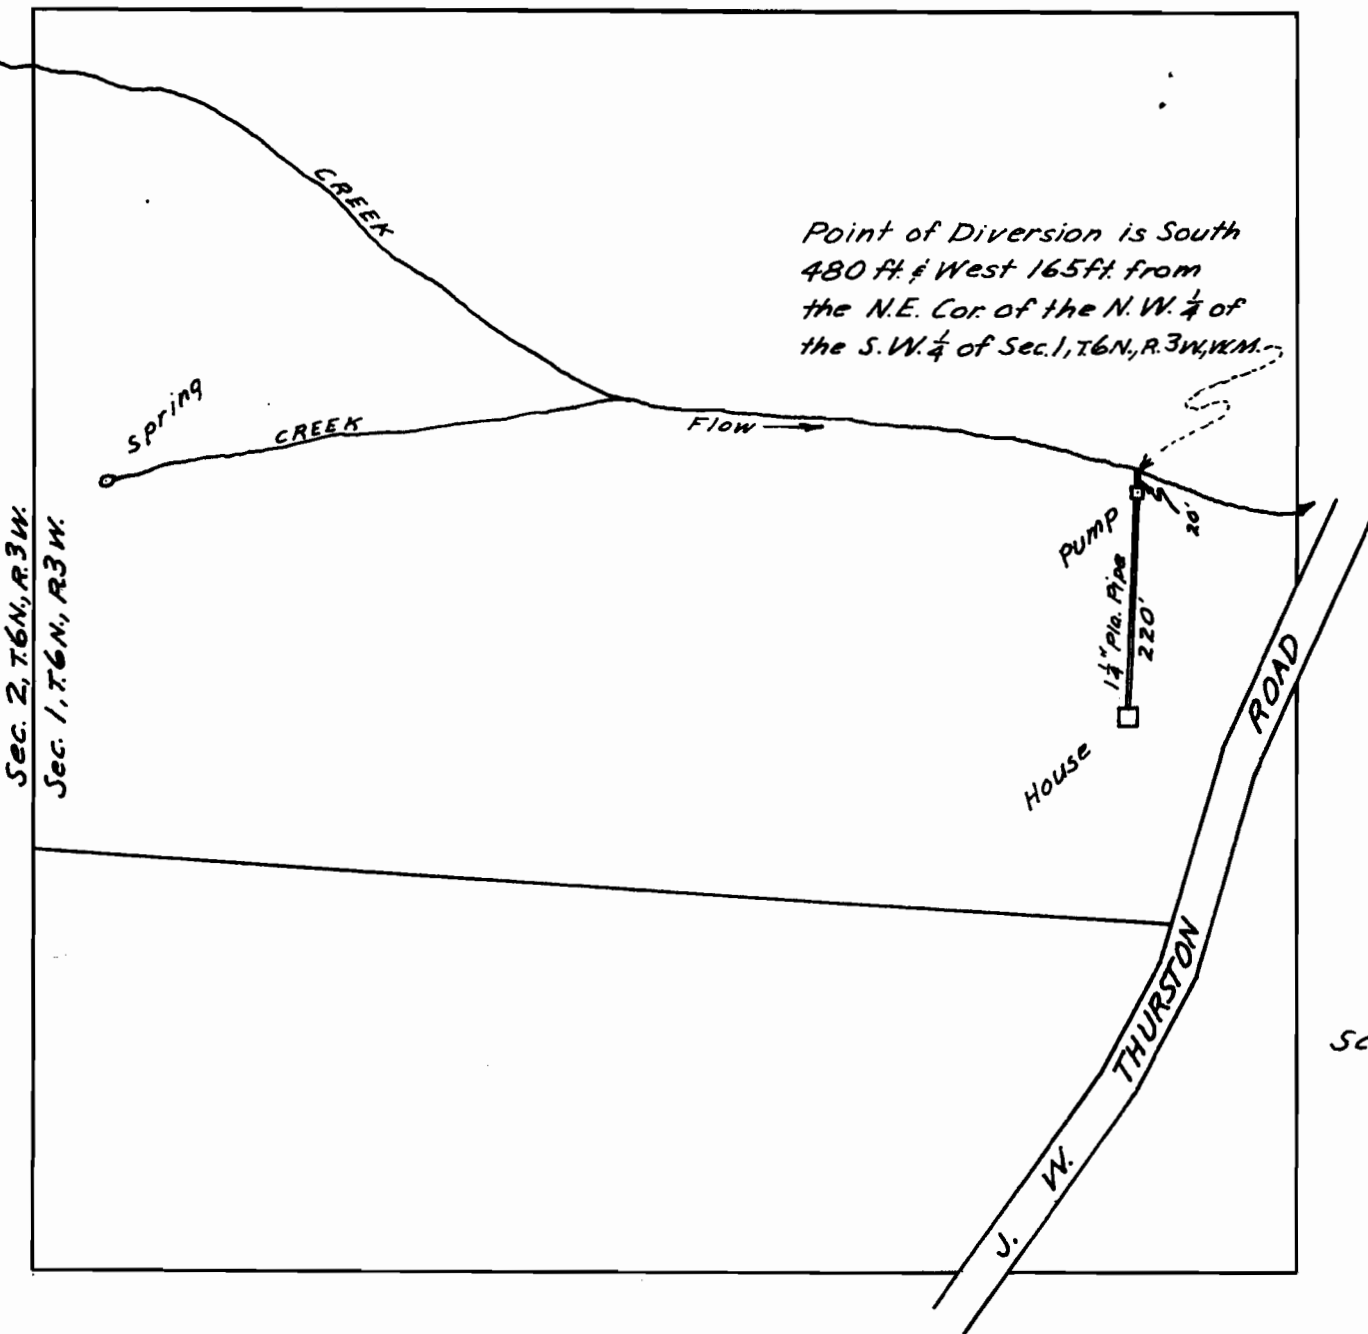

Scale: 1" = 200'

REGISTERED
 OREGON
 LAND SURVEYOR

Philip Dewey

JULY 12, 1968
 PHILIP DEWEY
 847

WATER RIGHT MAP
 FOR TED K. MALLORY
 IN SECTION 1, T.6N, R.3 W, W.M.
 COLUMBIA COUNTY, OREGON
 SEPTEMBER, 1970

Application No. 48949
 Permit No. 36652