


T.32&33S. R.14&15W. W.M.

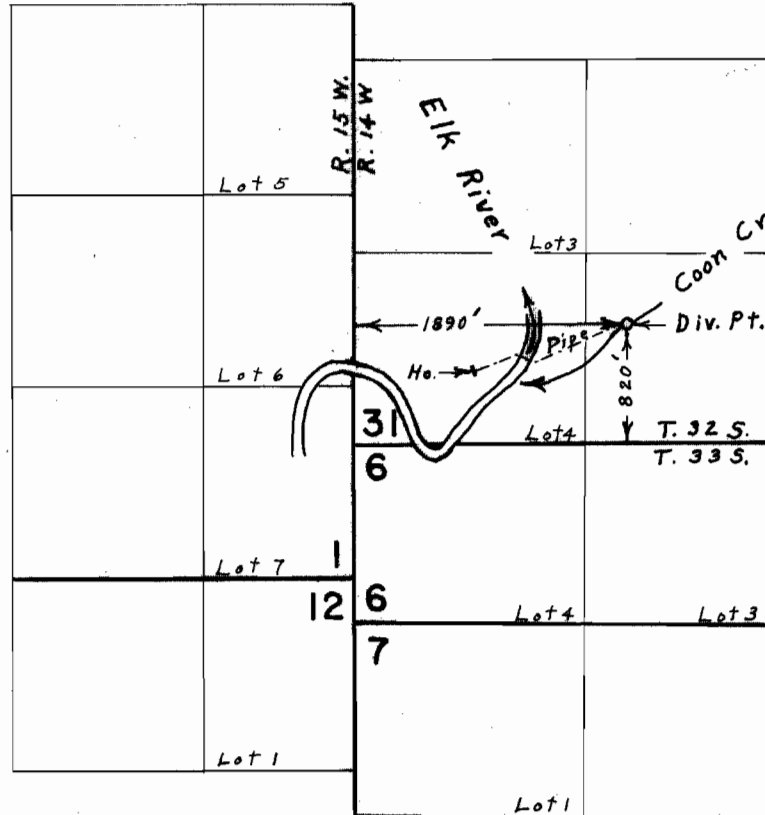

FINAL PROOF SURVEY UNDER

Application No. 44828 Permit No. 33569
IN NAME OF

JAY F. & ADELE O'LEARY

Surveyed Aug. 2 1973, by L. E. Gould