


T.26 S.R.3 W.W.M.

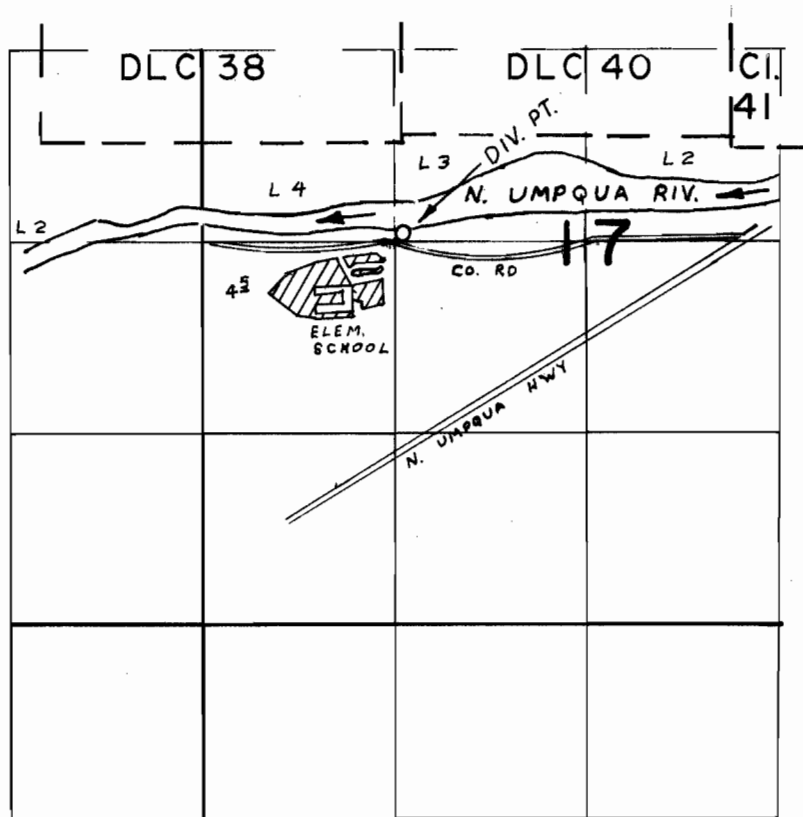

DIV. PT. LOC. 50' N & 1380' E FROM W 1/4 COR. SEC. 17

FINAL PROOF SURVEY UNDER

Application No. 39683 Permit No. 29623
IN NAME OF

DOUGLAS COUNTY SCHOOL DISTRICT No. 12

Surveyed AUG. 30 1974, by L. H. NUNN