


T.25S. R.5&6 W. W.M.

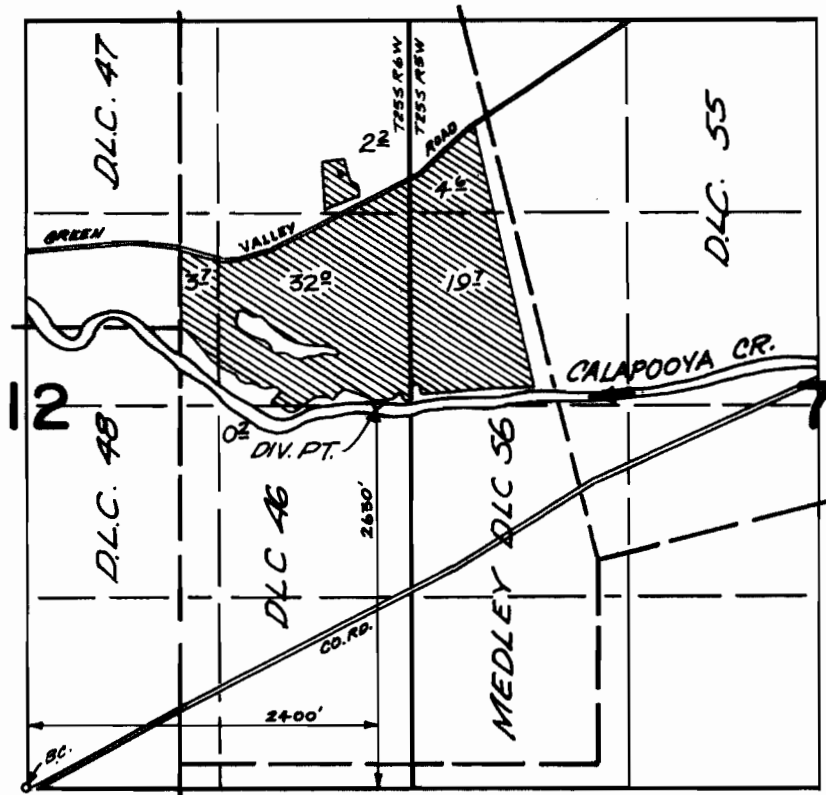

FINAL PROOF SURVEY UNDER

Application No. 43556 Permit No. 32050
IN NAME OF

CLAYTON E. WELLS

Surveyed AUGUST 20 1974, by A.M. TOLLA