


# T. 29 S. R. 5 W. W.M.

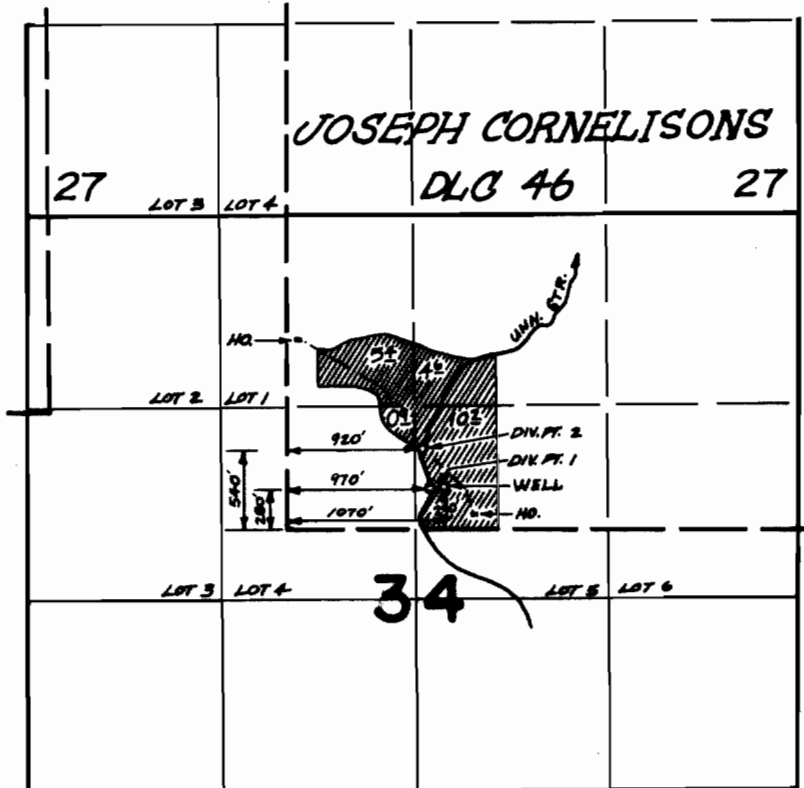

## FINAL PROOF SURVEY UNDER

Application No. 64837 45746 Permit No. 64558 34147 SUPPLEMENTAL  
PRIMARY  
IN NAME OF

GEORGE F. McNAUGHTON

Surveyed JUNE 20 1974, by D. NORBY