


T.30S. R.6W. W.M.

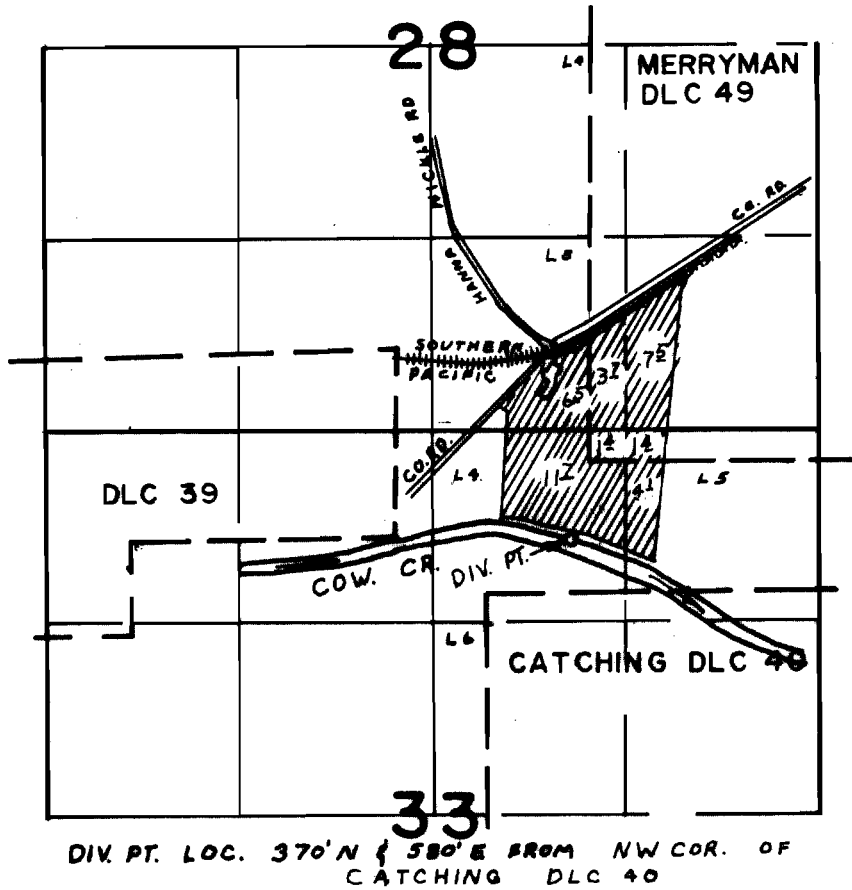

**FINAL PROOF SURVEY**  
UNDER

Application No. 45868 Permit No. 34245  
IN NAME OF

E. D. DAIGLE

Surveyed JULY 9 1974, by L. H. NUNN