


T.21 & 22S.R.5W.W.M.

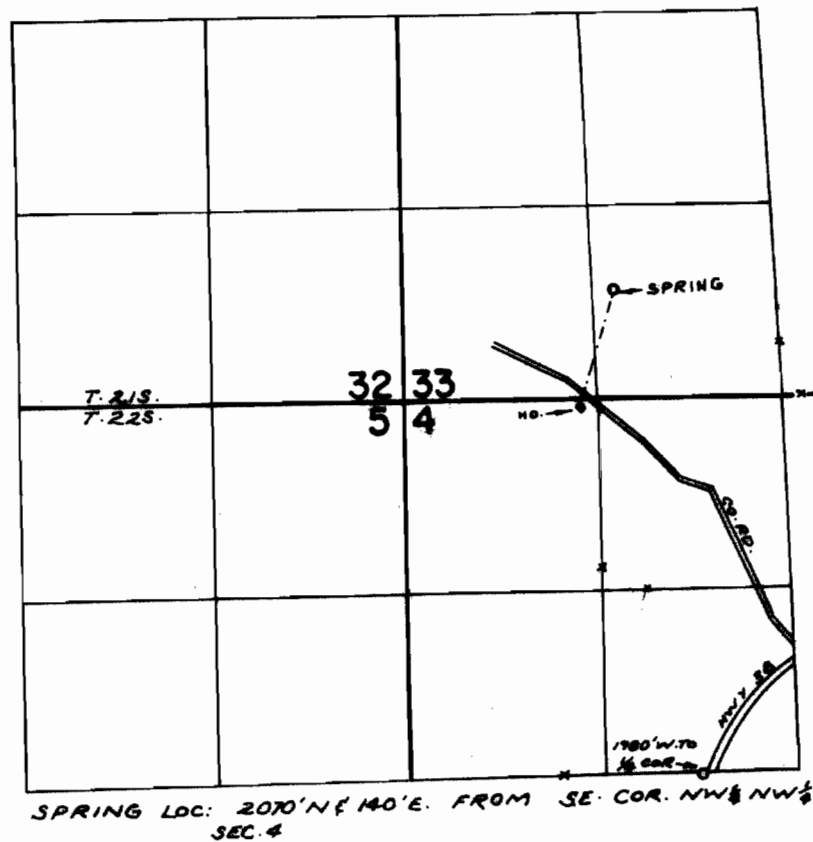

FINAL PROOF SURVEY
UNDER

Application No. 46620 Permit No. 34937
IN NAME OF

GORDON F. GURNEY

Surveyed MAY 2, 1974, by R. MUCKEN