


**T. 29 S. R. 4 W. W.M.**

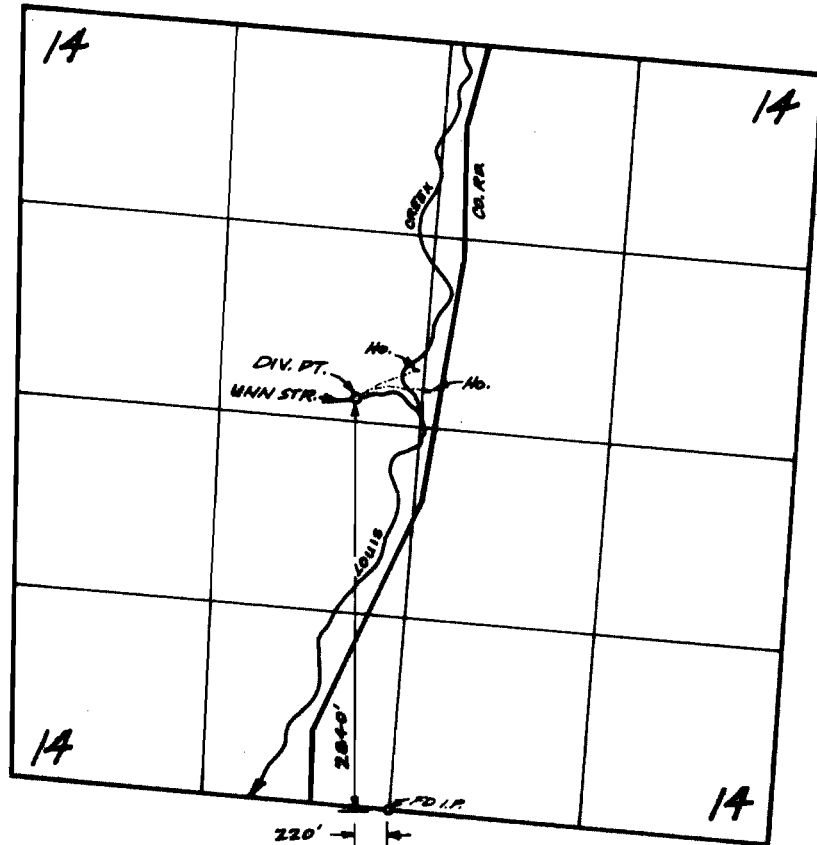

# FINAL PROOF SURVEY

## UNDER

Application No. 47190 Permit No. 35065  
IN NAME OF

CLIFFORD F UDELL

Surveyed JUNE 18 1974; by D. NORBY.....