


T.28S.R.6W.W.M.

LAND IRRIGATED
FROM:

RESV. A & B

RESV. C

RESV. D

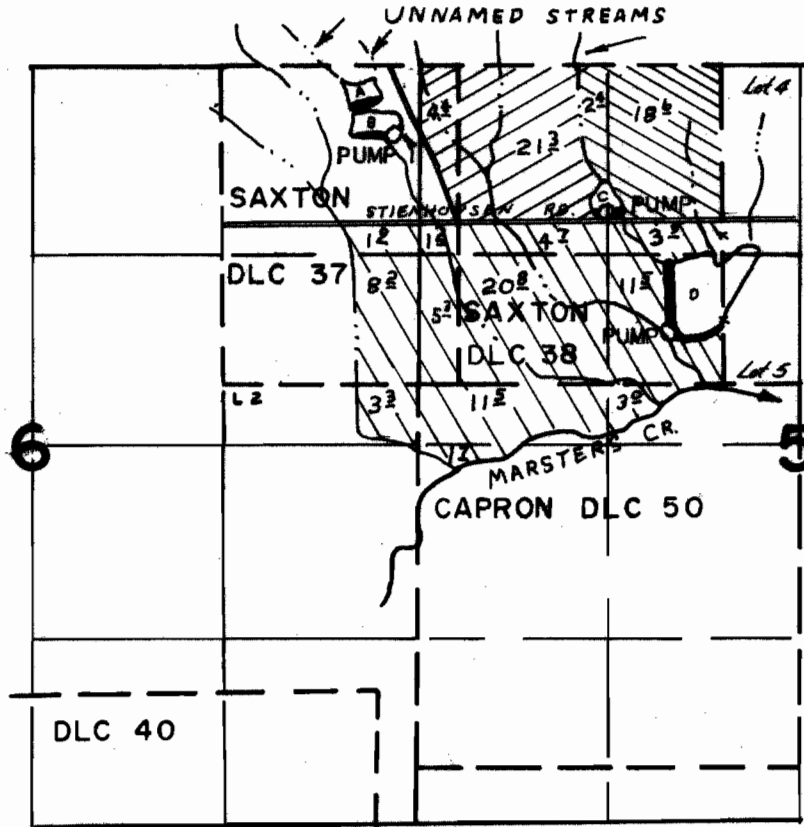

DAM A LOC. 1890' N 2450' W
 DAM B LOC. 1670' N 2400' W
 DAM C LOC. 1160' N 1320' W
 DAM D LOC. 330' N 370' W
 ALL FROM SE COR. SAXTON DLC 38

FINAL PROOF SURVEY UNDER

R-46531 R-5624
 R-47844 R-5632
 Application No. 47845 Permit No. 35121

IN NAME OF

STANFORD BUELL

Surveyed Aug. 27 1974, by L. H. NUNN