


T.24S.R.5W.W.M.

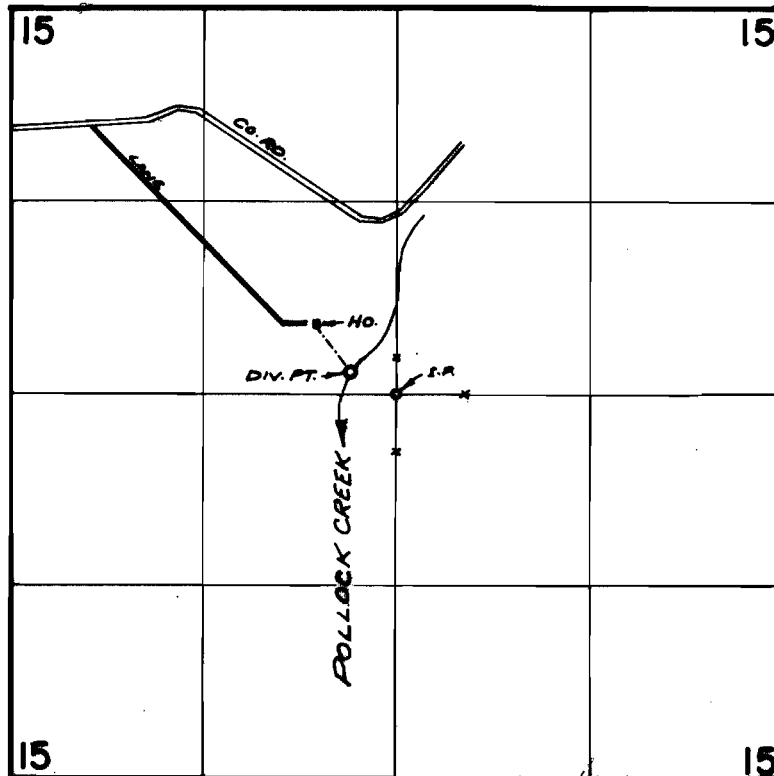

DIV. PT. LOC: 150' N. & 320' W. FROM CENTER SEC. 15

FINAL PROOF SURVEY
UNDER

Application No. 47707 Permit No. 35739
IN NAME OF

JAMES G. KNOTT

Surveyed OCT. 16 1924, by R. MUCKEN