


T.23S.R.4W.W.M.

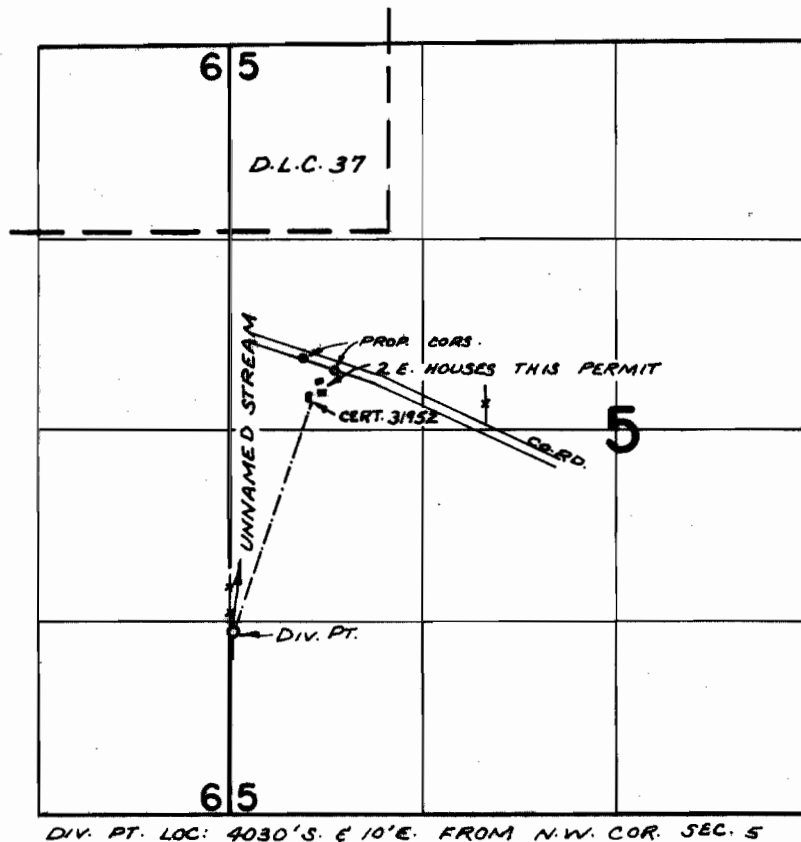

FINAL PROOF SURVEY
UNDER

Application No. 47617 Permit No. 35640
IN NAME OF

MARY A. GARRISON

Surveyed OCT. 16, 1974, by R.G. MUCKEN