


T.30 S. R.6W. W.M.

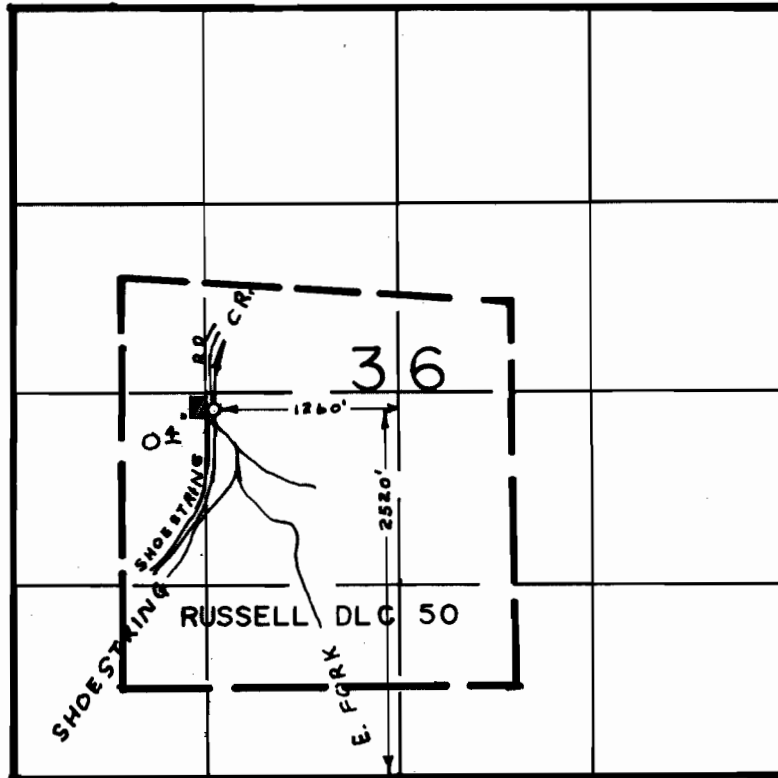

FINAL PROOF SURVEY
UNDER

Application No. 48426 Permit No. 36351
IN NAME OF

GORDON G. KUK

Surveyed JULY 10 1974, by L.H. NUNN