


# T.27S.R.6W.W.M.

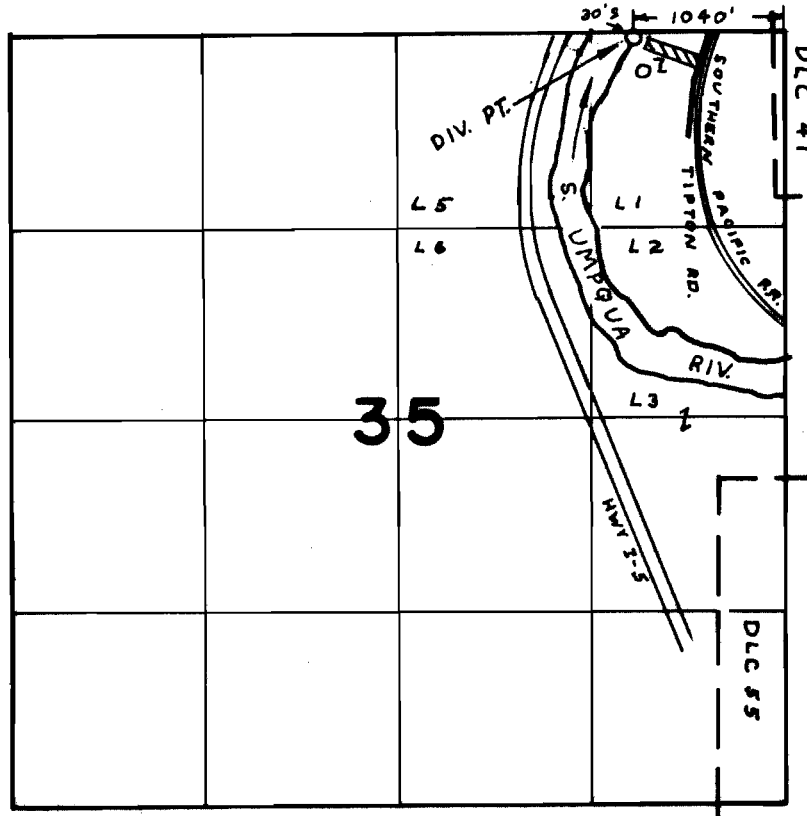

## FINAL PROOF SURVEY UNDER

Application No. 48542 Permit No. 36433  
IN NAME OF

PAUL DALE NORRIS

Surveyed AUG. 27, 1974, by L. H. NUNN