


T.26S.R.4W.W.M.

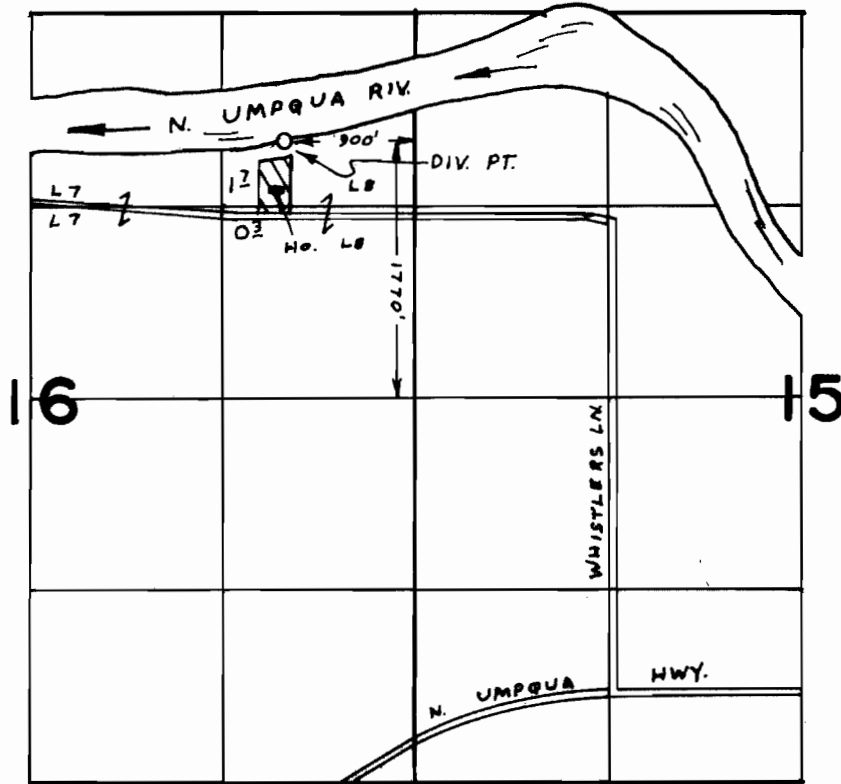

FINAL PROOF SURVEY UNDER

Application No. 49076 Permit No. 36815
IN NAME OF

ISTHMIAN L. & MARY POWELL

Surveyed AUG. 29 1974, by L. H. NUNN