


T. 28 S. R. 6 W. W.M.

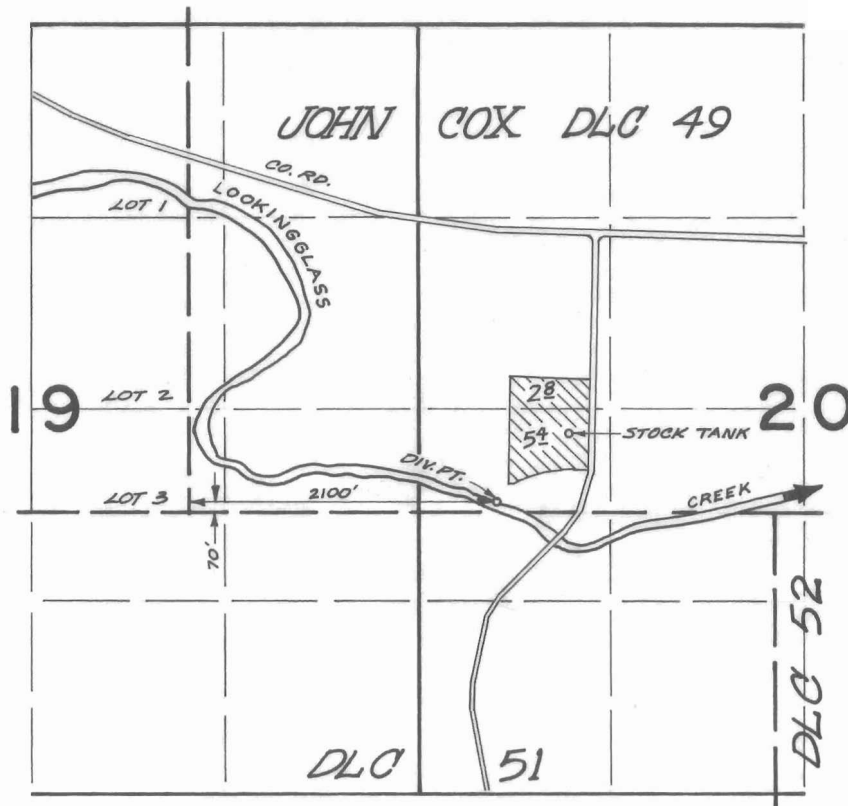

FINAL PROOF SURVEY
UNDER

Application No. 49477 Permit No. 37061
IN NAME OF
J. MARK GIBSON

Surveyed JUNE 17 1974, by D.M. NORBY.