


C42733

T.18 S. R.26 E. W.M.

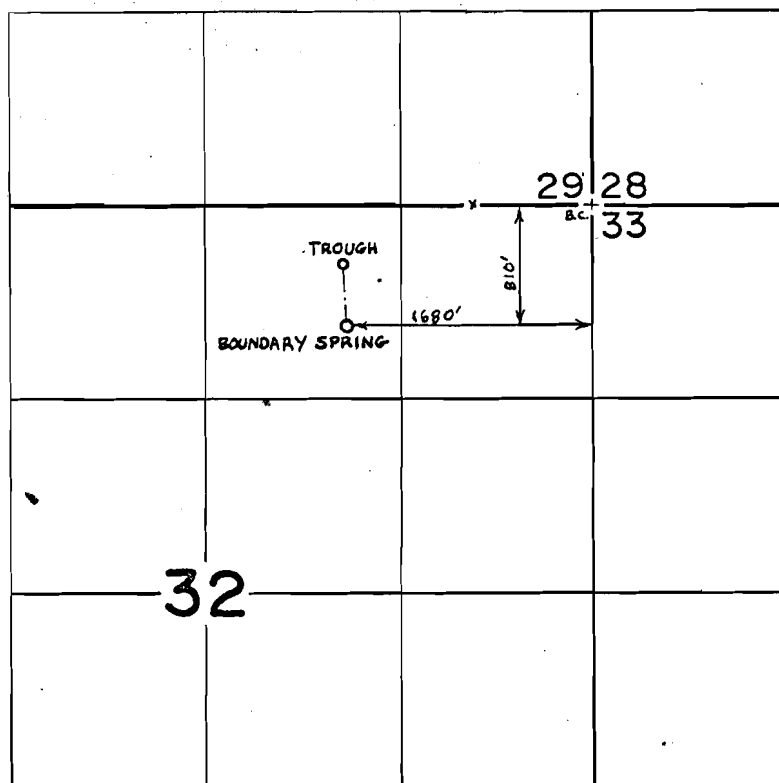

FINAL PROOF SURVEY
UNDER

Application No. 37543 Permit No. 28030
IN NAME OF

UNITED STATES DEPT. OF AGRICULTURE

Surveyed OCT. 5, 1974, by D. NORBY

P#28030
PFS-1974-C 2p