


T.39S.R.3W.W.M.

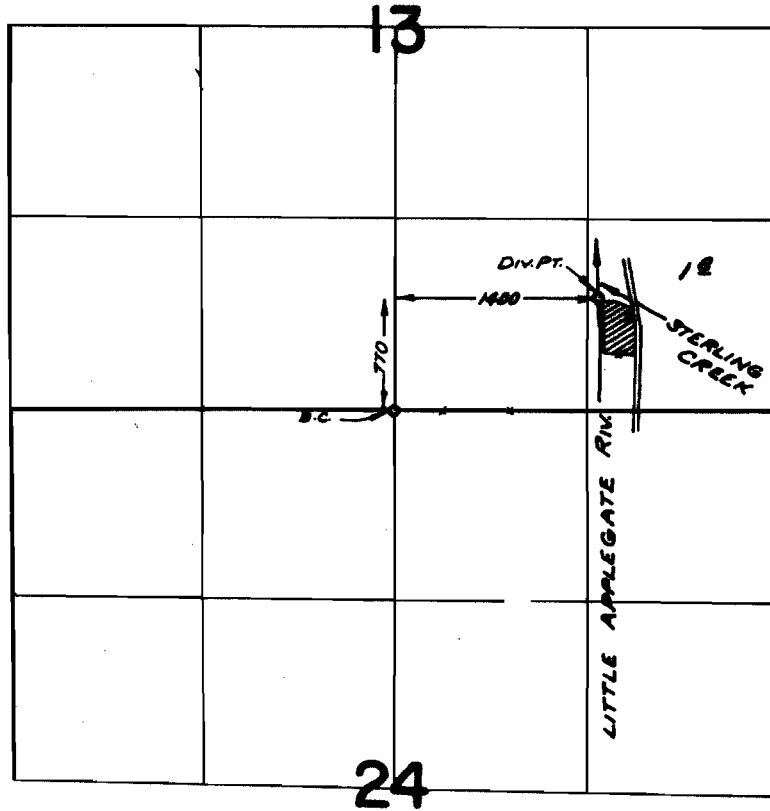

FINAL PROOF SURVEY UNDER

Application No. 46343... Permit No. 34622...
IN NAME OF

.....DOUGLAS B. KITSELMAN.....

Surveyed SEPT. 24, 1974., by R. MUCKEN