


T.35S. R.5W. W.M.

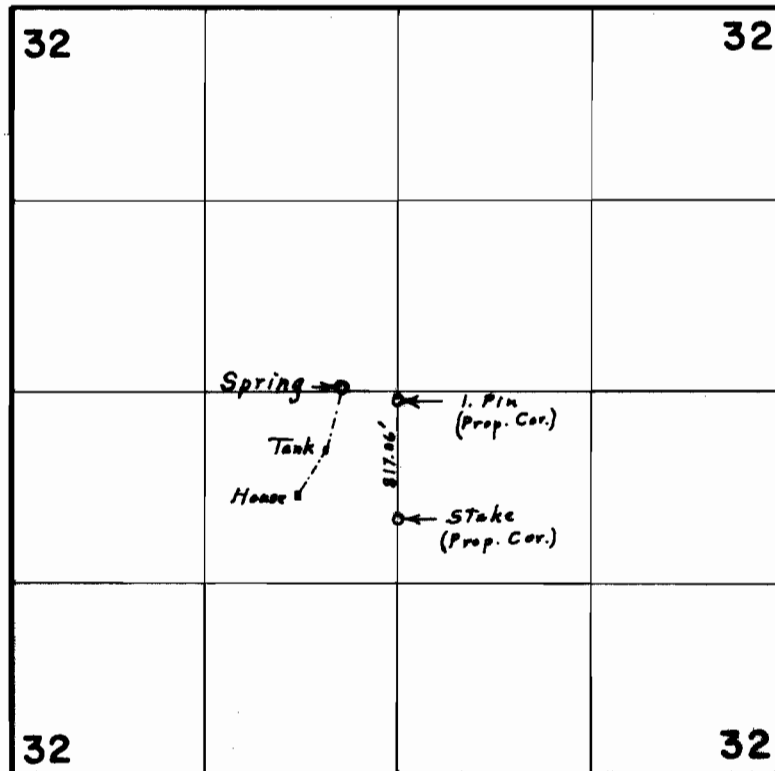

Spring located 1350' N. & 388' W. from S.E. Cor. N.E.  $\frac{1}{4}$  S.W.  $\frac{1}{4}$  Sec. 32.

**FINAL PROOF SURVEY**  
UNDER

Application No. 44423 Permit No. 34744  
IN NAME OF

**CHARLES H. & MARY GENE RETZLOFF**

Surveyed April 17, 1974, by L. E. Gould