


T.37S., R.11 1/2 E., W.M.

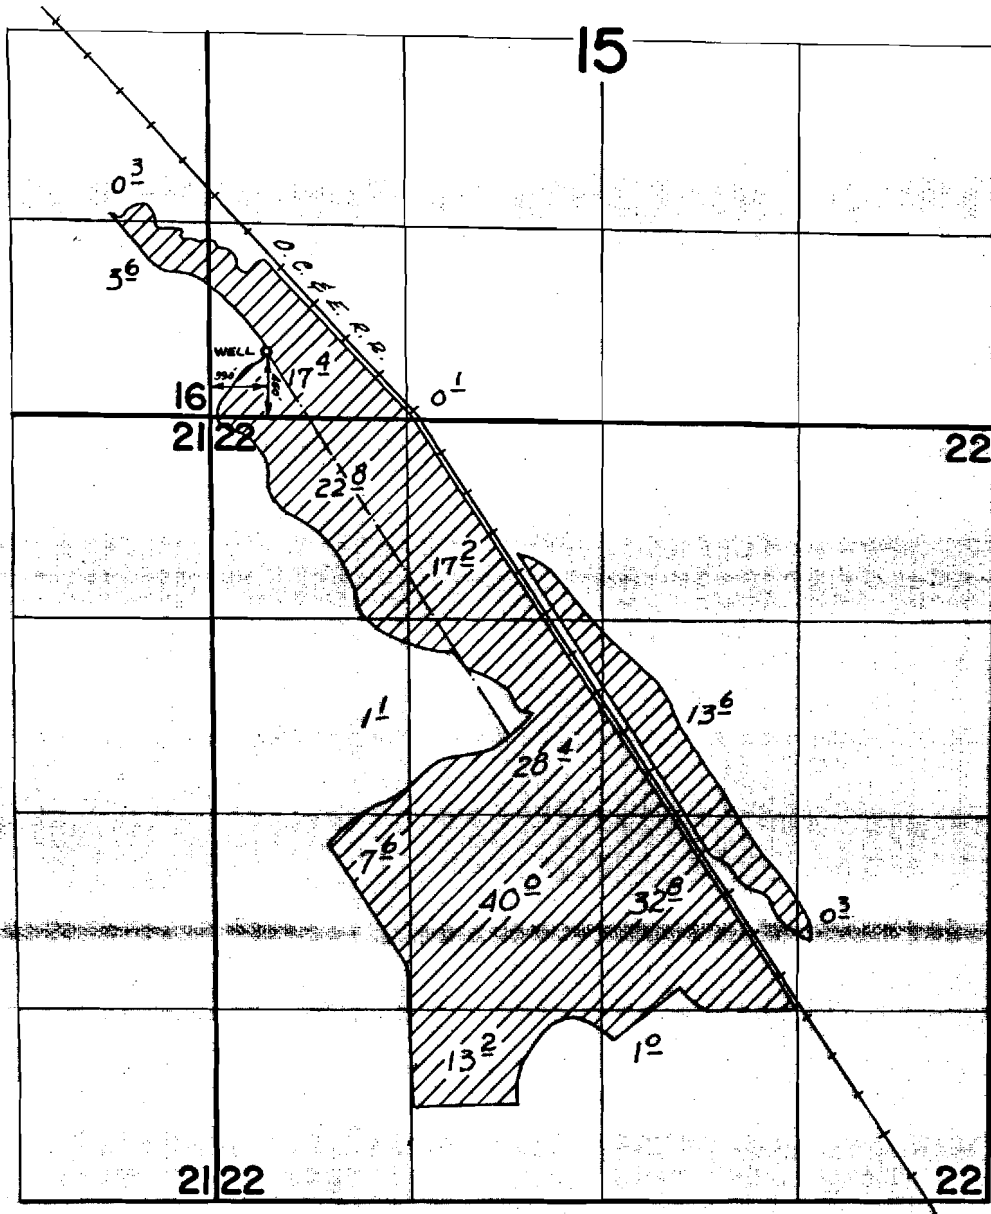

**FINAL PROOF SURVEY**  
UNDER

Application No. G-1948 Permit No. G-1790  
IN NAME OF

L. L. STEWART AND L. E. CHAPMAN

Surveyed Oct. 31 1974, by D.M. Norby