

G-3774

G-3774

FINAL PROOF SURVEY

UNDER

APPLICATION NO. G-3760

PERMIT NO. G-3774

IN NAME OF


DAYTON O. & GERDA V. HYDE


SURVEYED OCT 23, 1974 BY L.H. NUNN


T.32 & 33 S. R.I.E. W.M.

--	--	--	--



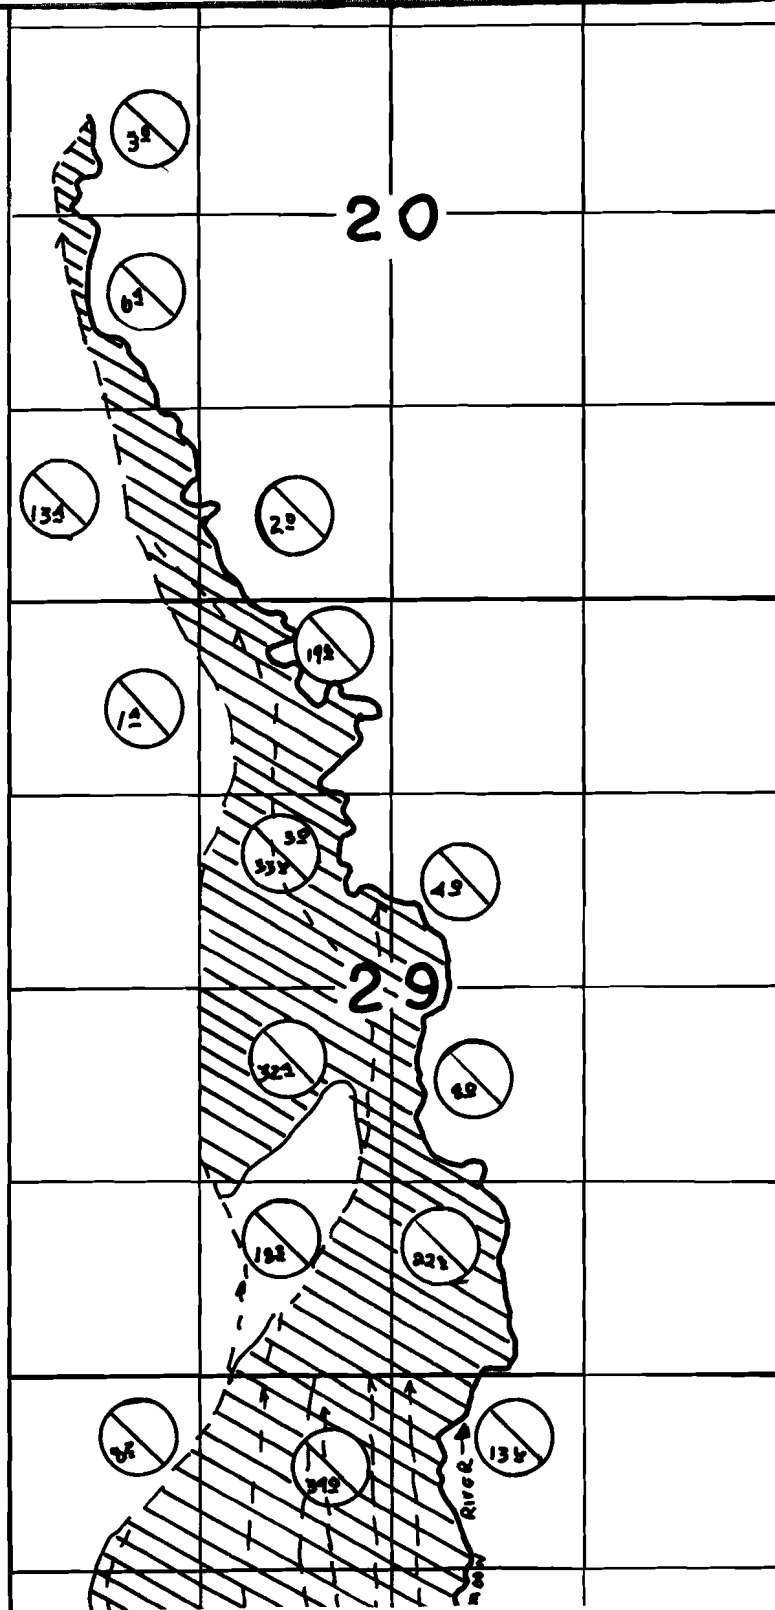

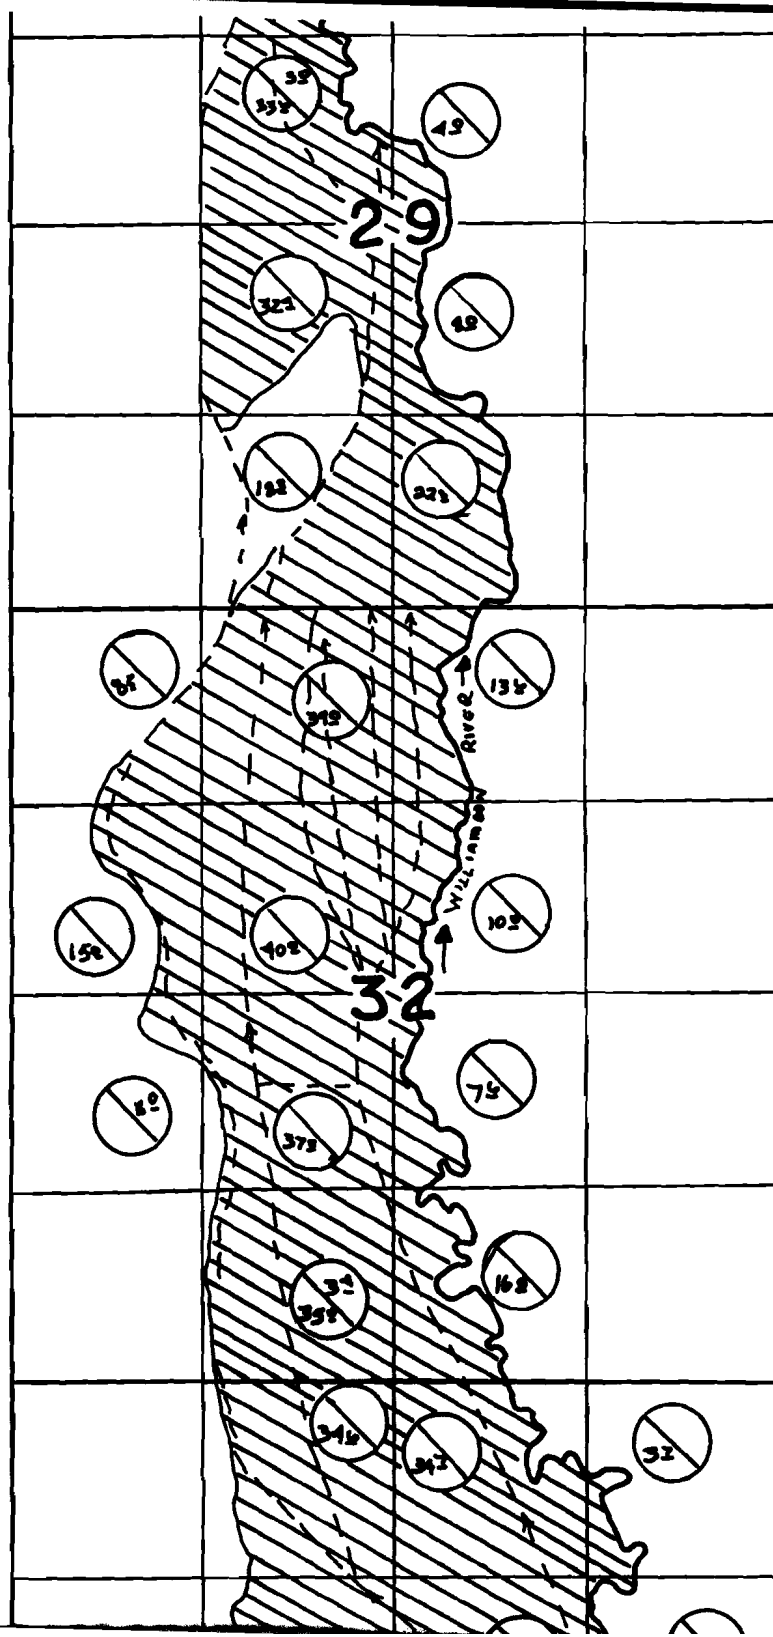

 PRIMARY
 SUPPLEMENTAL

T325
 T335.

