


G-3878

42741

T. 38 &amp; 39 S., R. 8 E., W.M.

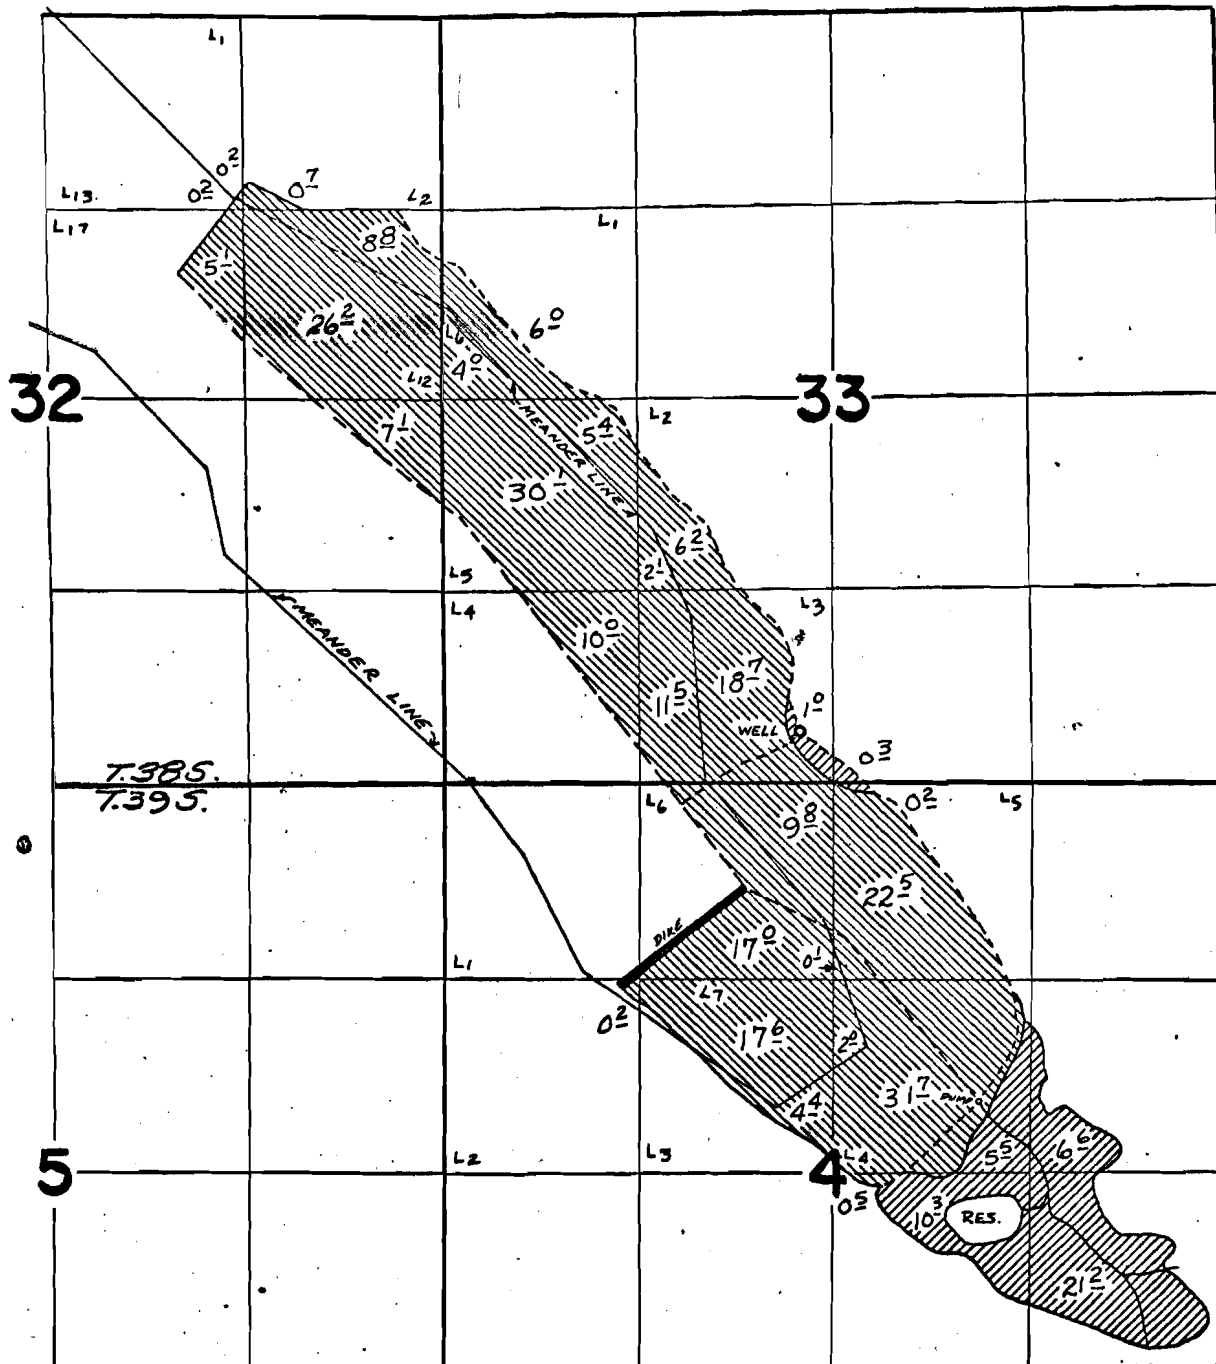

WELL LOCATED: 350' N &amp; 220' W FROM S 1/4 COR. SEC. 33.

FINAL PROOF SURVEY  
UNDERApplication No. G-4122 Permit No. G-3878  
IN NAME OF

CRESWELLS, INC.

Surveyed Nov. 1, 1974, by D.M. Norby