


# T.36S.R.14E.W.M.

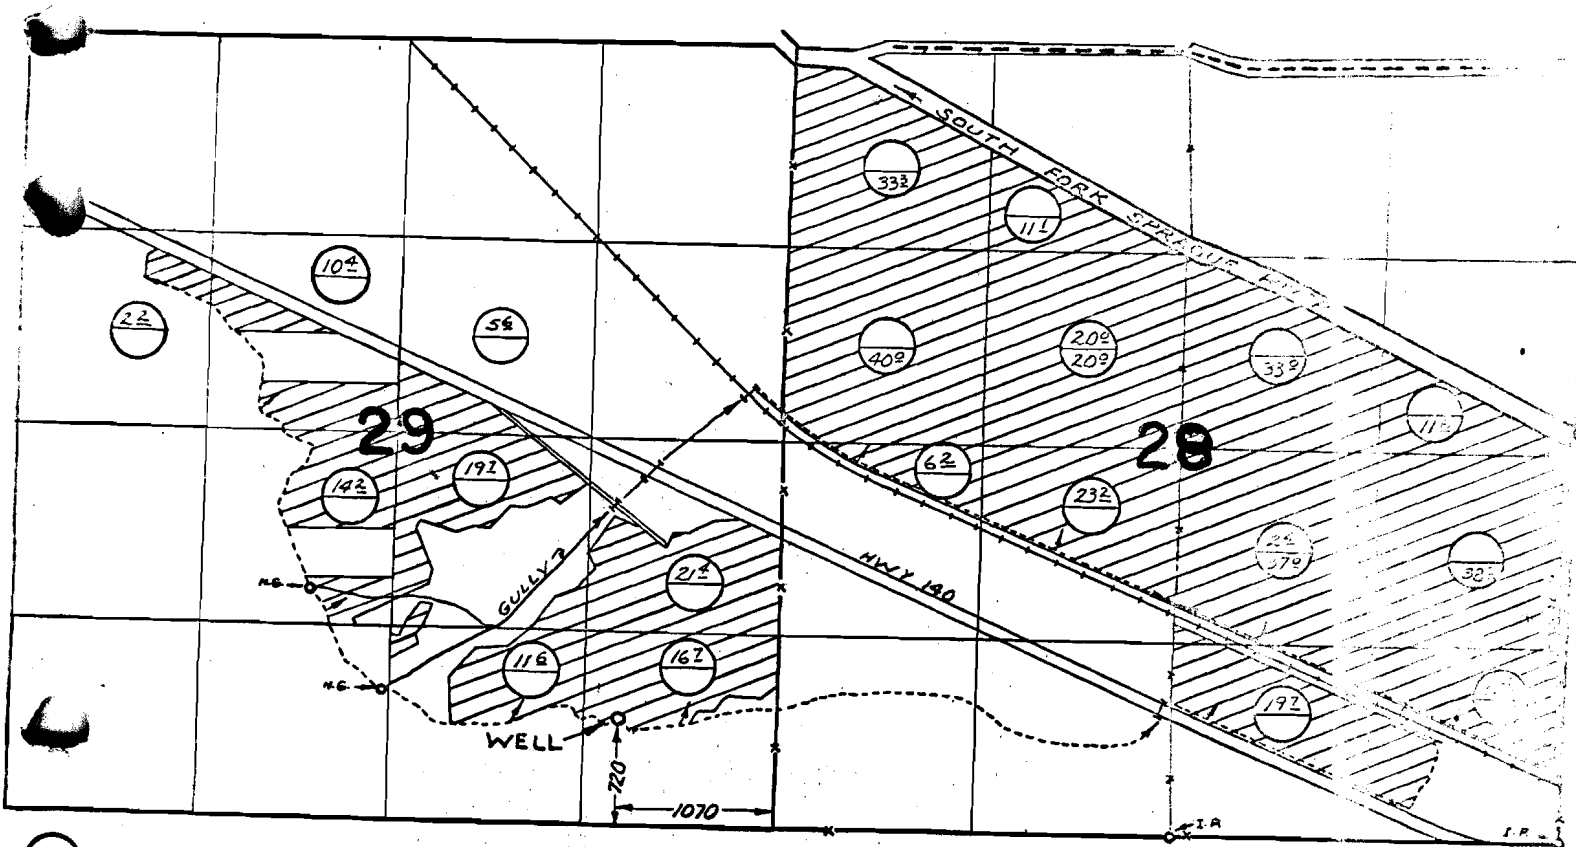

 PRIMARY  
 SUPPLEMENTAL

## FINAL PROOF SURVEY

UNDER

Application No. G-5309 Permit No. G-4835

IN NAME OF

CARSON P. & ELIZABETH M. MERKLEY

Surveyed OCT 30 19 74, by R. MUCKEN

*S. J. K. Spague Re. wells.*