


T.38S., R.11 1/2 E., W.M.

Buck creek + Yonna Valley wells

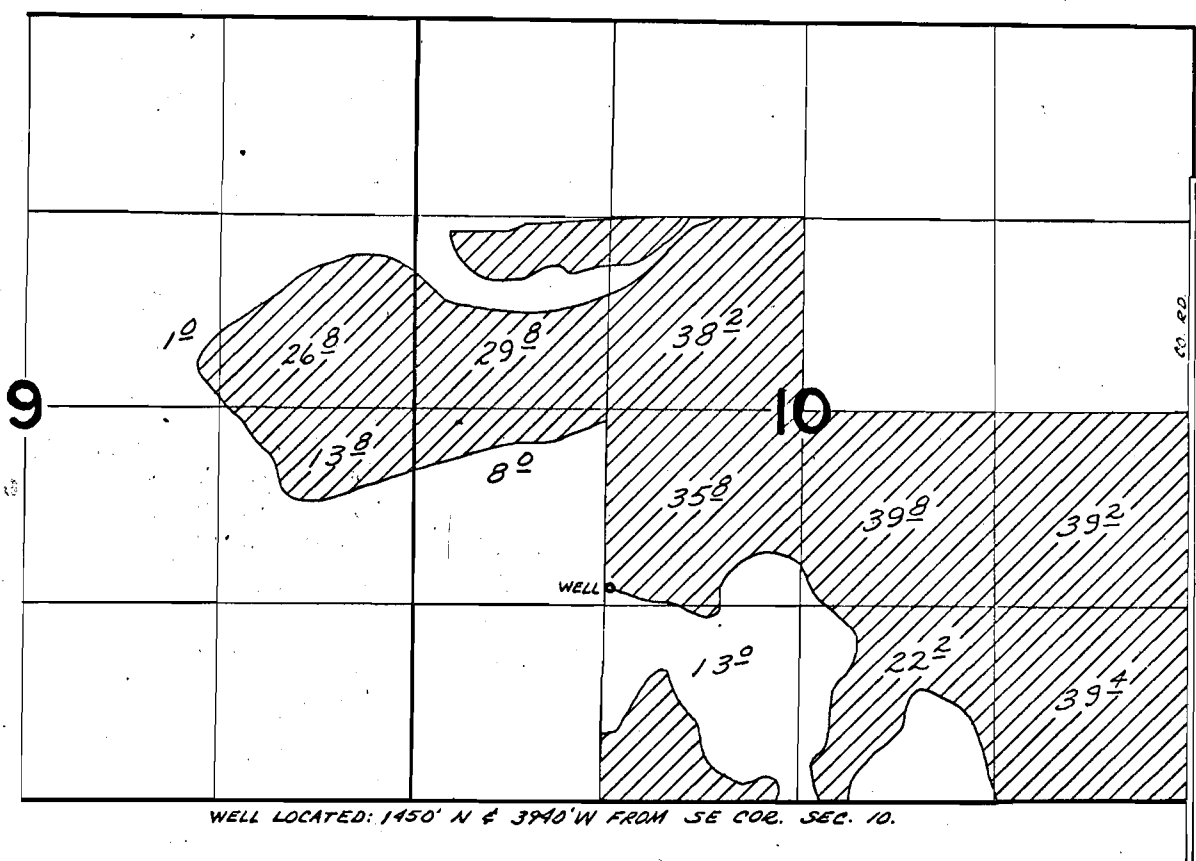

FINAL PROOF SURVEY UNDER

Application No. G-5307 Permit No. G-5135
IN NAME OF

RICHARD G. GARNER

Surveyed Oct. 23 1974, by D.M. Norby