


# T.35S. R.7E. W.M.

Williamson Riv. - Klamath Marsh

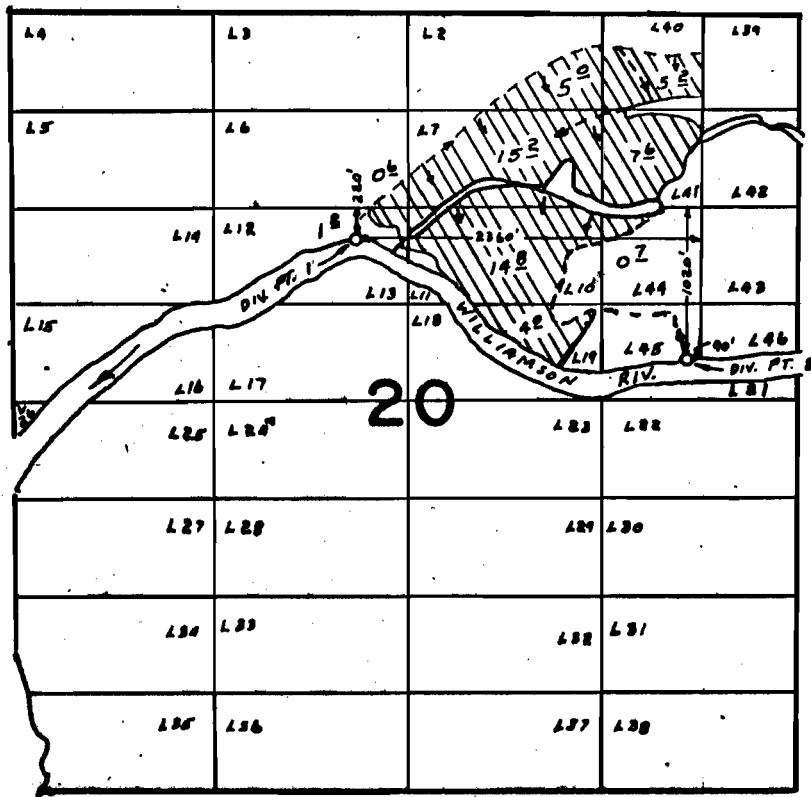

## FINAL PROOF SURVEY UNDER

Application No. 41088 Permit No. 30801  
IN NAME OF

HENRY G. WOLFF

Surveyed OCT. 17 1974, by L.H. NUNN