


T.34S. R.8E. W.M.

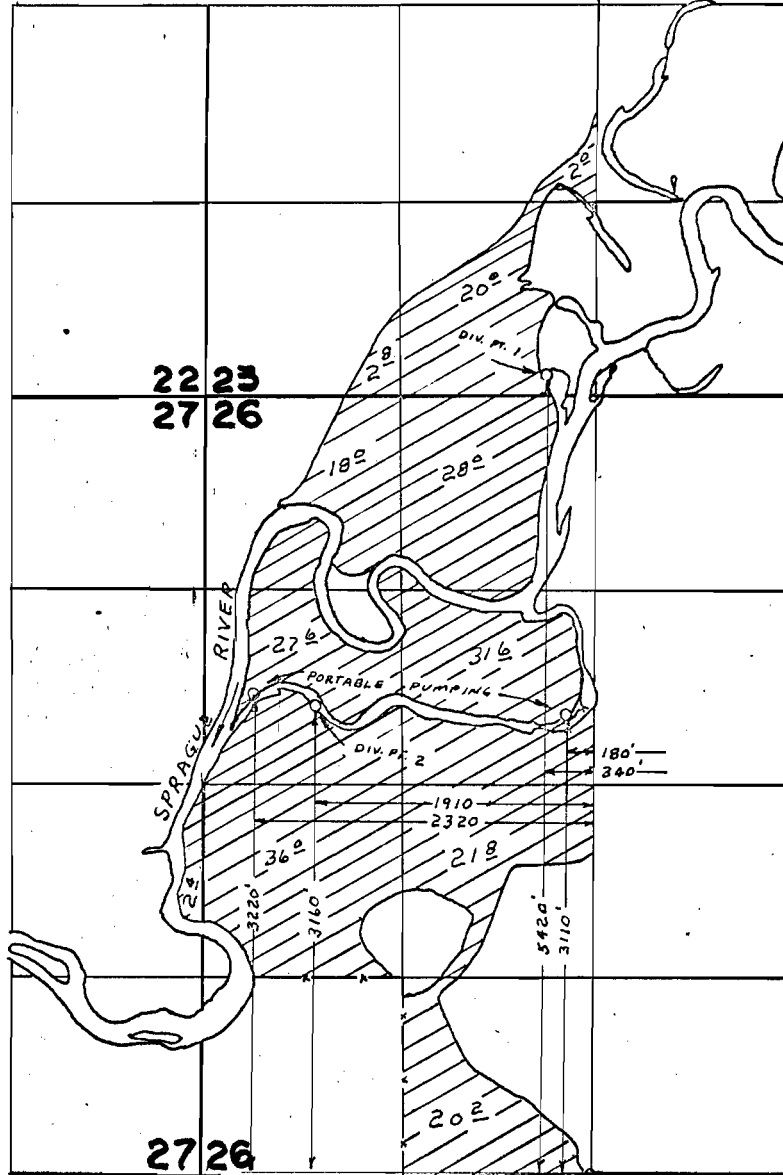

FINAL PROOF SURVEY
UNDER

Application No. 43174 Permit No. 32272
IN NAME OF

JESSE F. & HILDA E. FRANCIS

Surveyed OCT 19 1974, by LH NUNN

Sprague River