

P-7114-1
Nov. 1965

UNITED STATES
DEPARTMENT OF THE INTERIOR
BUREAU OF LAND MANAGEMENT

34168
42750


SECTION

2

Oregon State Water Filings

TOWNSHIP 41S, RANGE 14 1/2E, W. M.

North

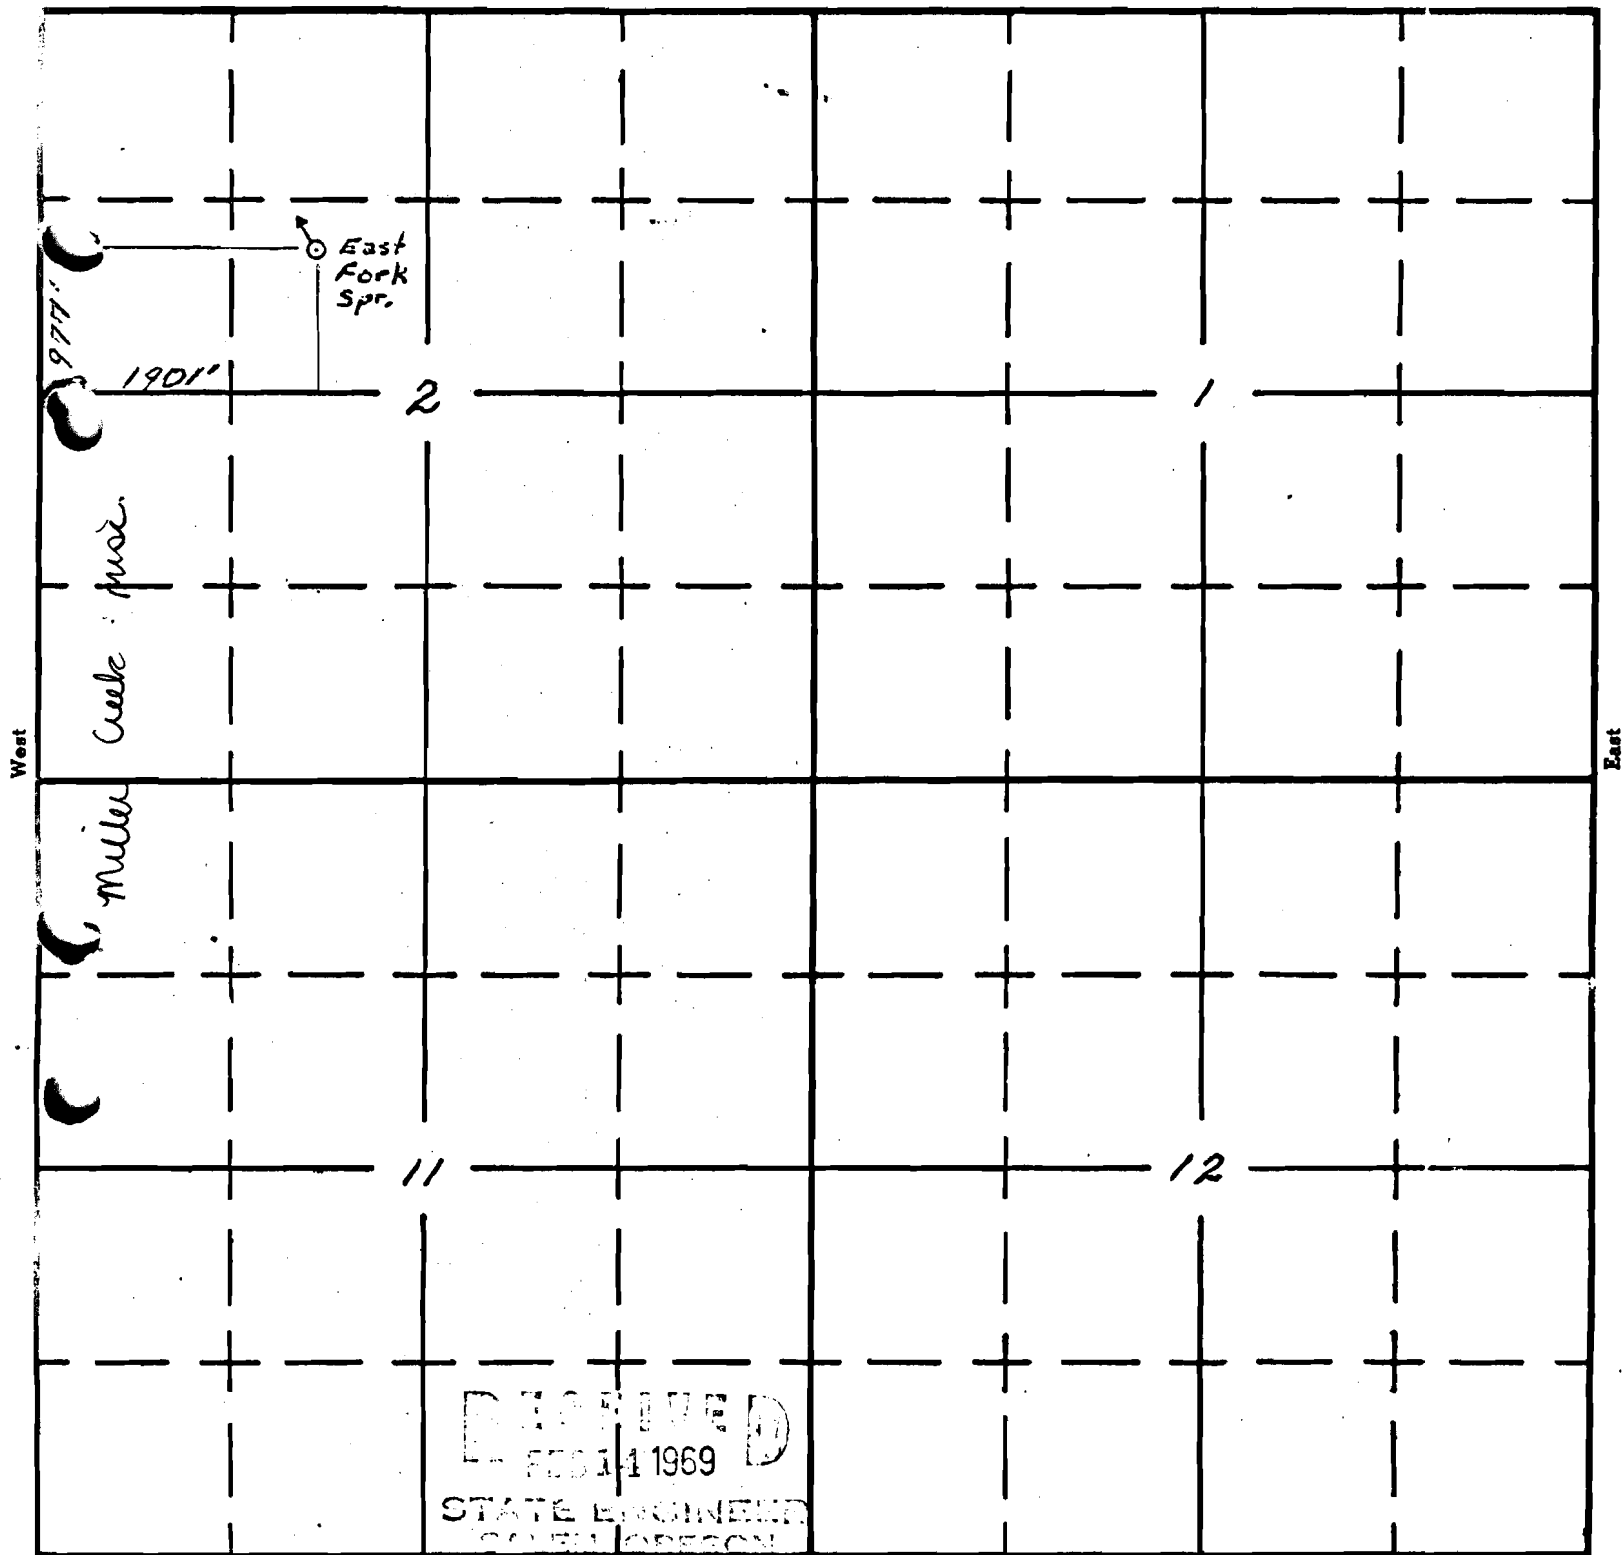

South

RECEIVED
FEB 14 1969
STATE ENGINEER

APPLICATION No. 45773
PERMIT No. 34168