


T.34S. R.7E. W.M.

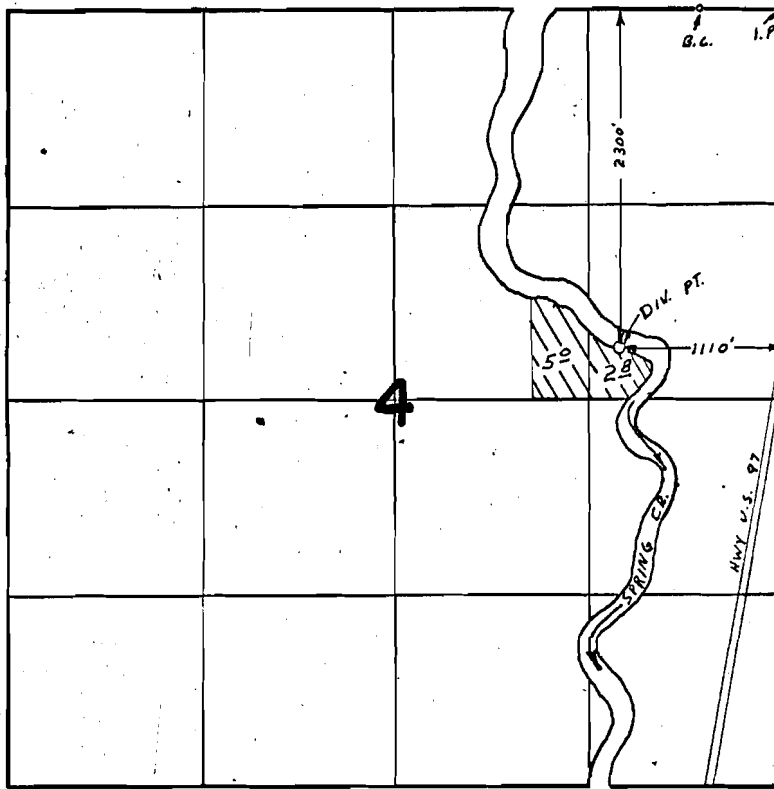

Spring Creek Misc.

FINAL PROOF SURVEY UNDER

Application No. 46189 Permit No. 34515
IN NAME OF

DONALD M. LEFLER

Surveyed OCT. 16. 1974, by LH NUNN