


34523

42752

T.34S. R.7W. W.M.

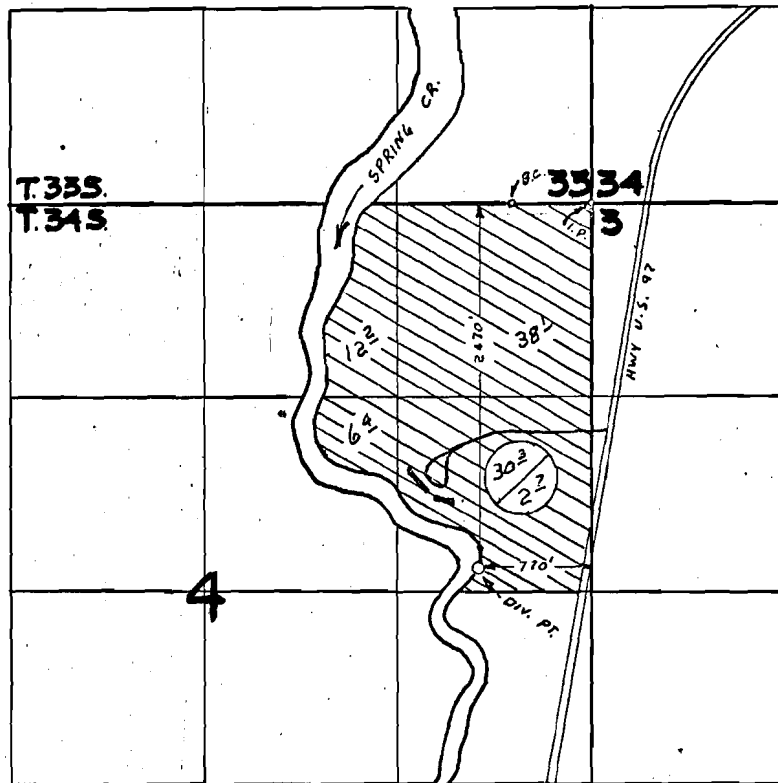

PERMIT 34523
 CERT. 33421

FINAL PROOF SURVEY UNDER

Application No. 46206 Permit No. 34523
 IN NAME OF

MARION C. RIBBLE

Surveyed OCT 16 1974, by LH NUNN

Spring Creek Mac