
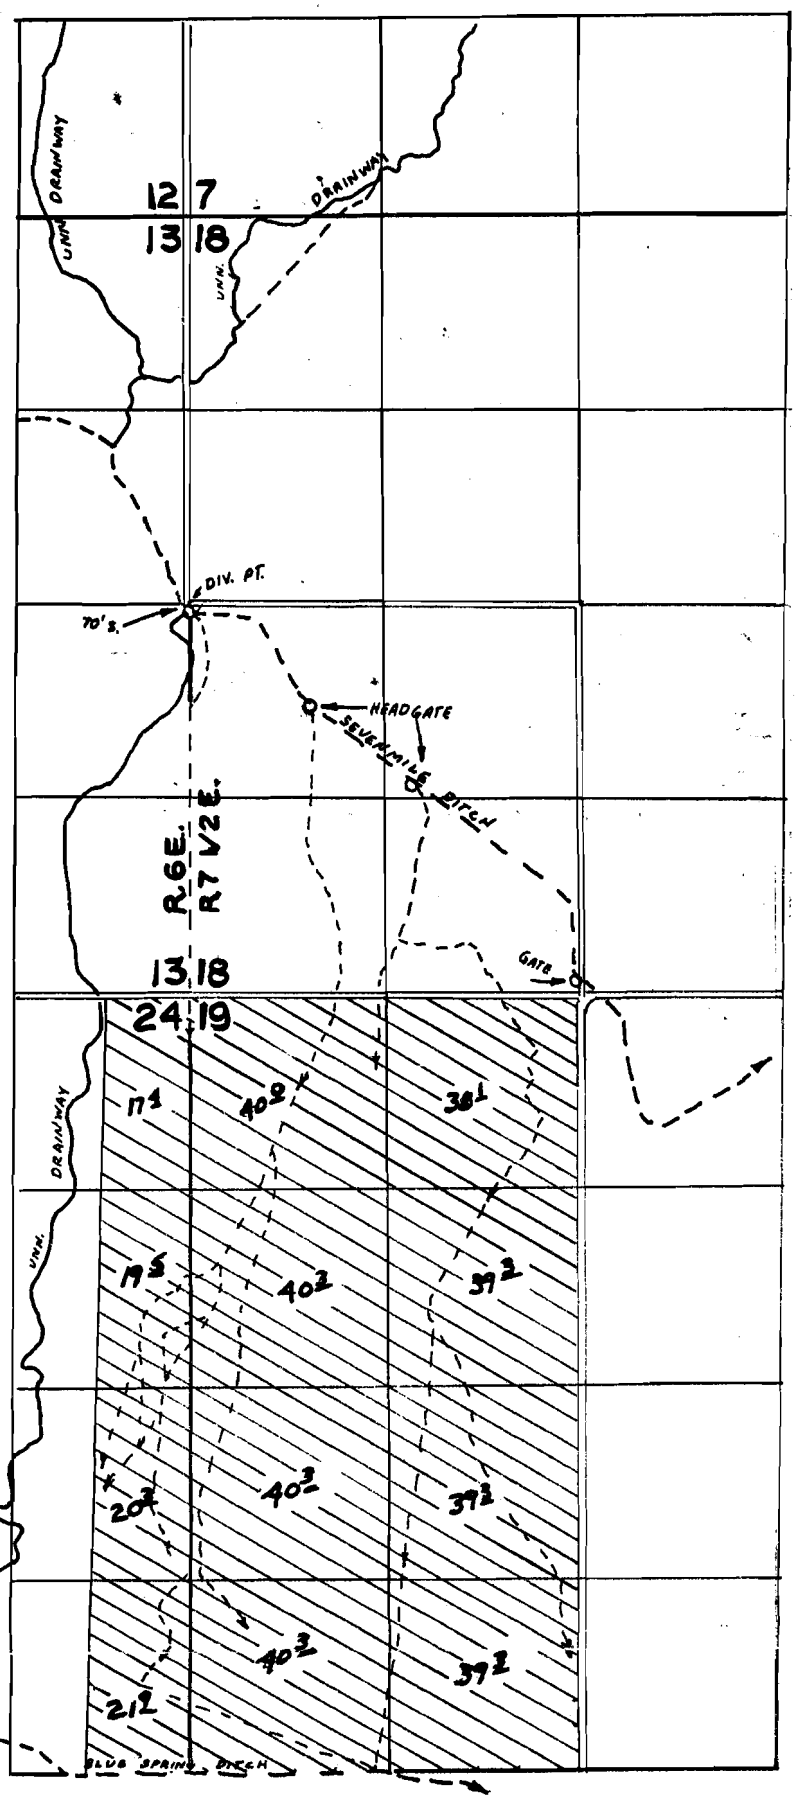


T.33S. R.6 & 7-1/2 E. W.M.

T.33S. R.6E. W.M.

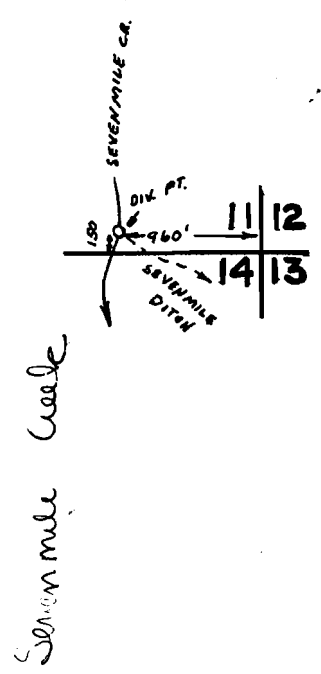

FINAL PROOF SURVEY  
UNDER

**FINAL PROOF SURVEY  
UNDER**

APPLICATION No. <sup>47196</sup>47197 PERMIT No. <sup>35523</sup>35524

**IN NAME OF**

**LLOYD NICHOLSON**

**SURVEYED OCT. 19, 1974 BY L H NUNN**

CNO-233-9 LHN