


37147

42756

T.35&36S., R.10E., W.M.

Sprague River

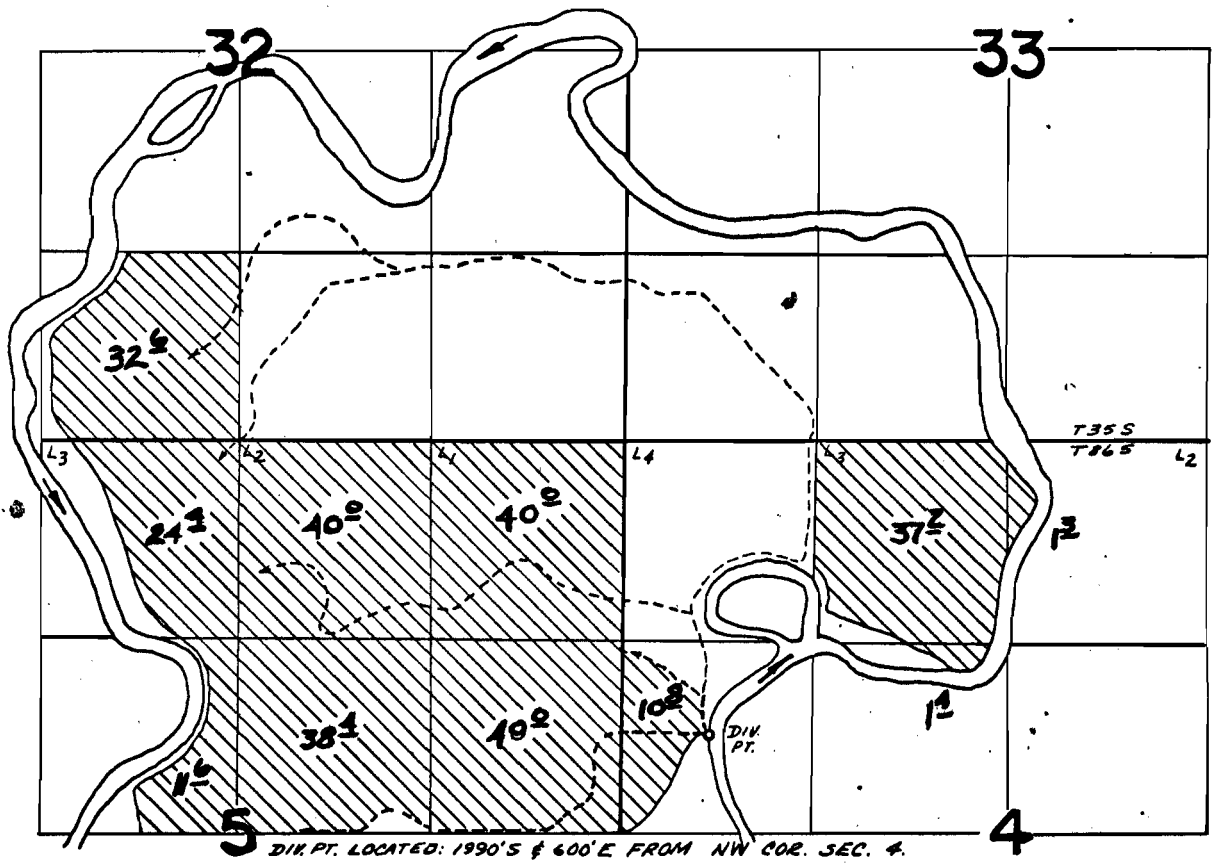

FINAL PROOF SURVEY UNDER

Application No. 51497 Permit No. 37147
IN NAME OF

JOSEPH AND FRANCES A. CABRAL AND RICHARD CABRAL

Surveyed Oct. 31 1974, by D.M.Norby