


T.I.S. R.I.W. W.M.

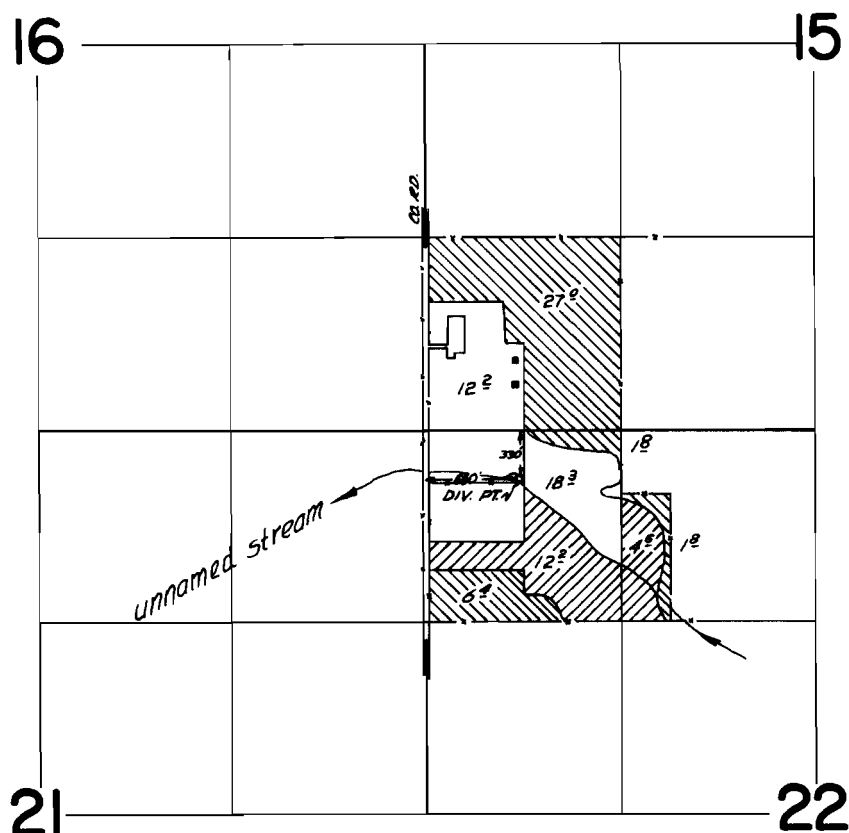

FINAL PROOF SURVEY
UNDER

Application No. 45395 Permit No. 34112
IN NAME OF

DAVID P. and HUGUETTE C. RICHARDS

Surveyed June 5 1912, by D.R. Buell