


T. 11 S. R. 1 W. W.M.

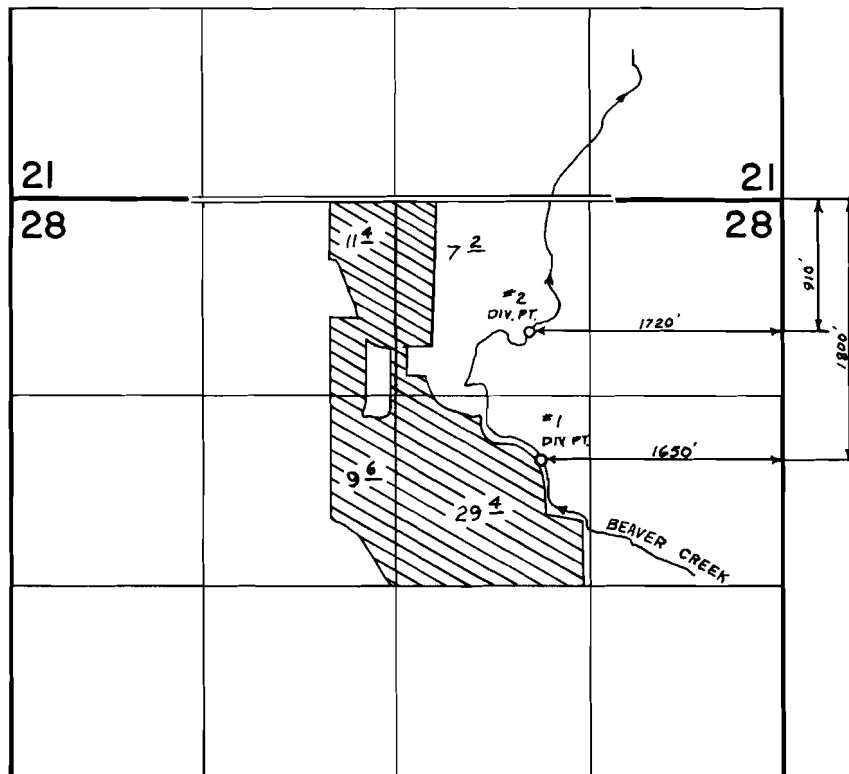

FINAL PROOF SURVEY
UNDER

Application No. 47241 Permit No. 35066
IN NAME OF

ROY P. STOLSIG JR. & ROSE MARIE STOLSIG

Surveyed JULY 25 1973, by L.E. GOULD