


T.8S.R.2W.W.M.

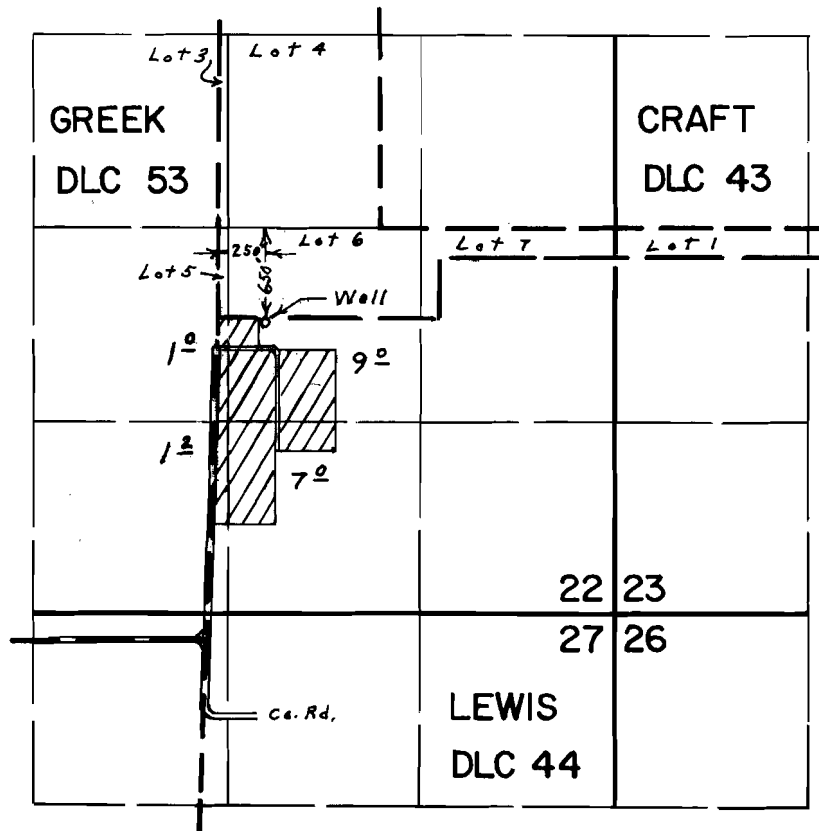

FINAL PROOF SURVEY
UNDER

Application No. G-4265 Permit No. G-4017

IN NAME OF

DON BURKLAND

Surveyed MAY 14 1973, by L.E. GOULD