


G-4338
42760

T.4S., R.26E., W.M.

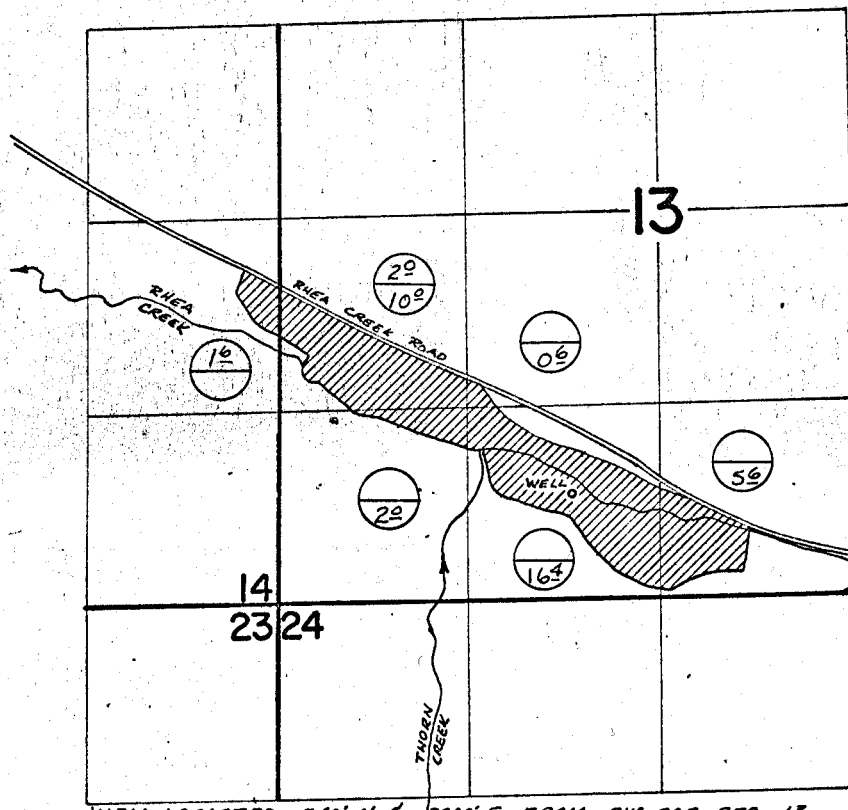

WELL LOCATED: 740' N & 2000' E FROM SW COR SEC. 13.

 SUPPLEMENTAL
PRIMARY

FINAL PROOF SURVEY UNDER

Application No. G-4615 Permit No. G-4338
IN NAME OF

JAMES H. & BARBARA HAYES

Surveyed May 7 1974, by D. Dorby