T. 7S. R. 4W. W.M.

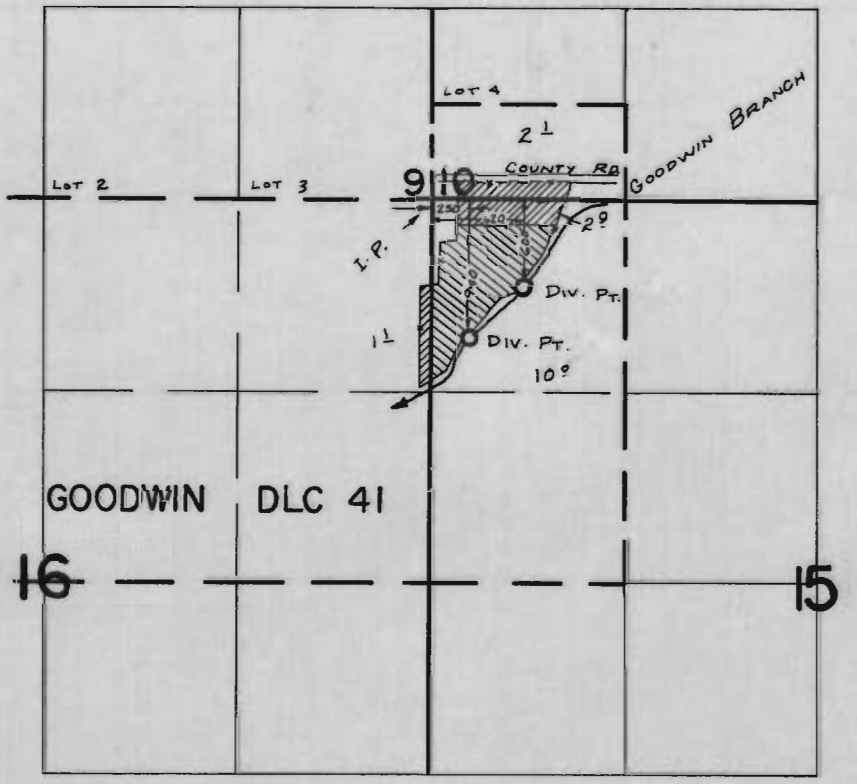

FINAL PROOF SURVEY
UNDER

Application No. 47799 41097 Permit No. 35809 30612

IN NAME OF

WILLIAM E. DOMES

Surveyed SEPT. 3 1969, by D. BUELL
APRIL 24 1974 T. J. PACK

B.M.
1967-C